





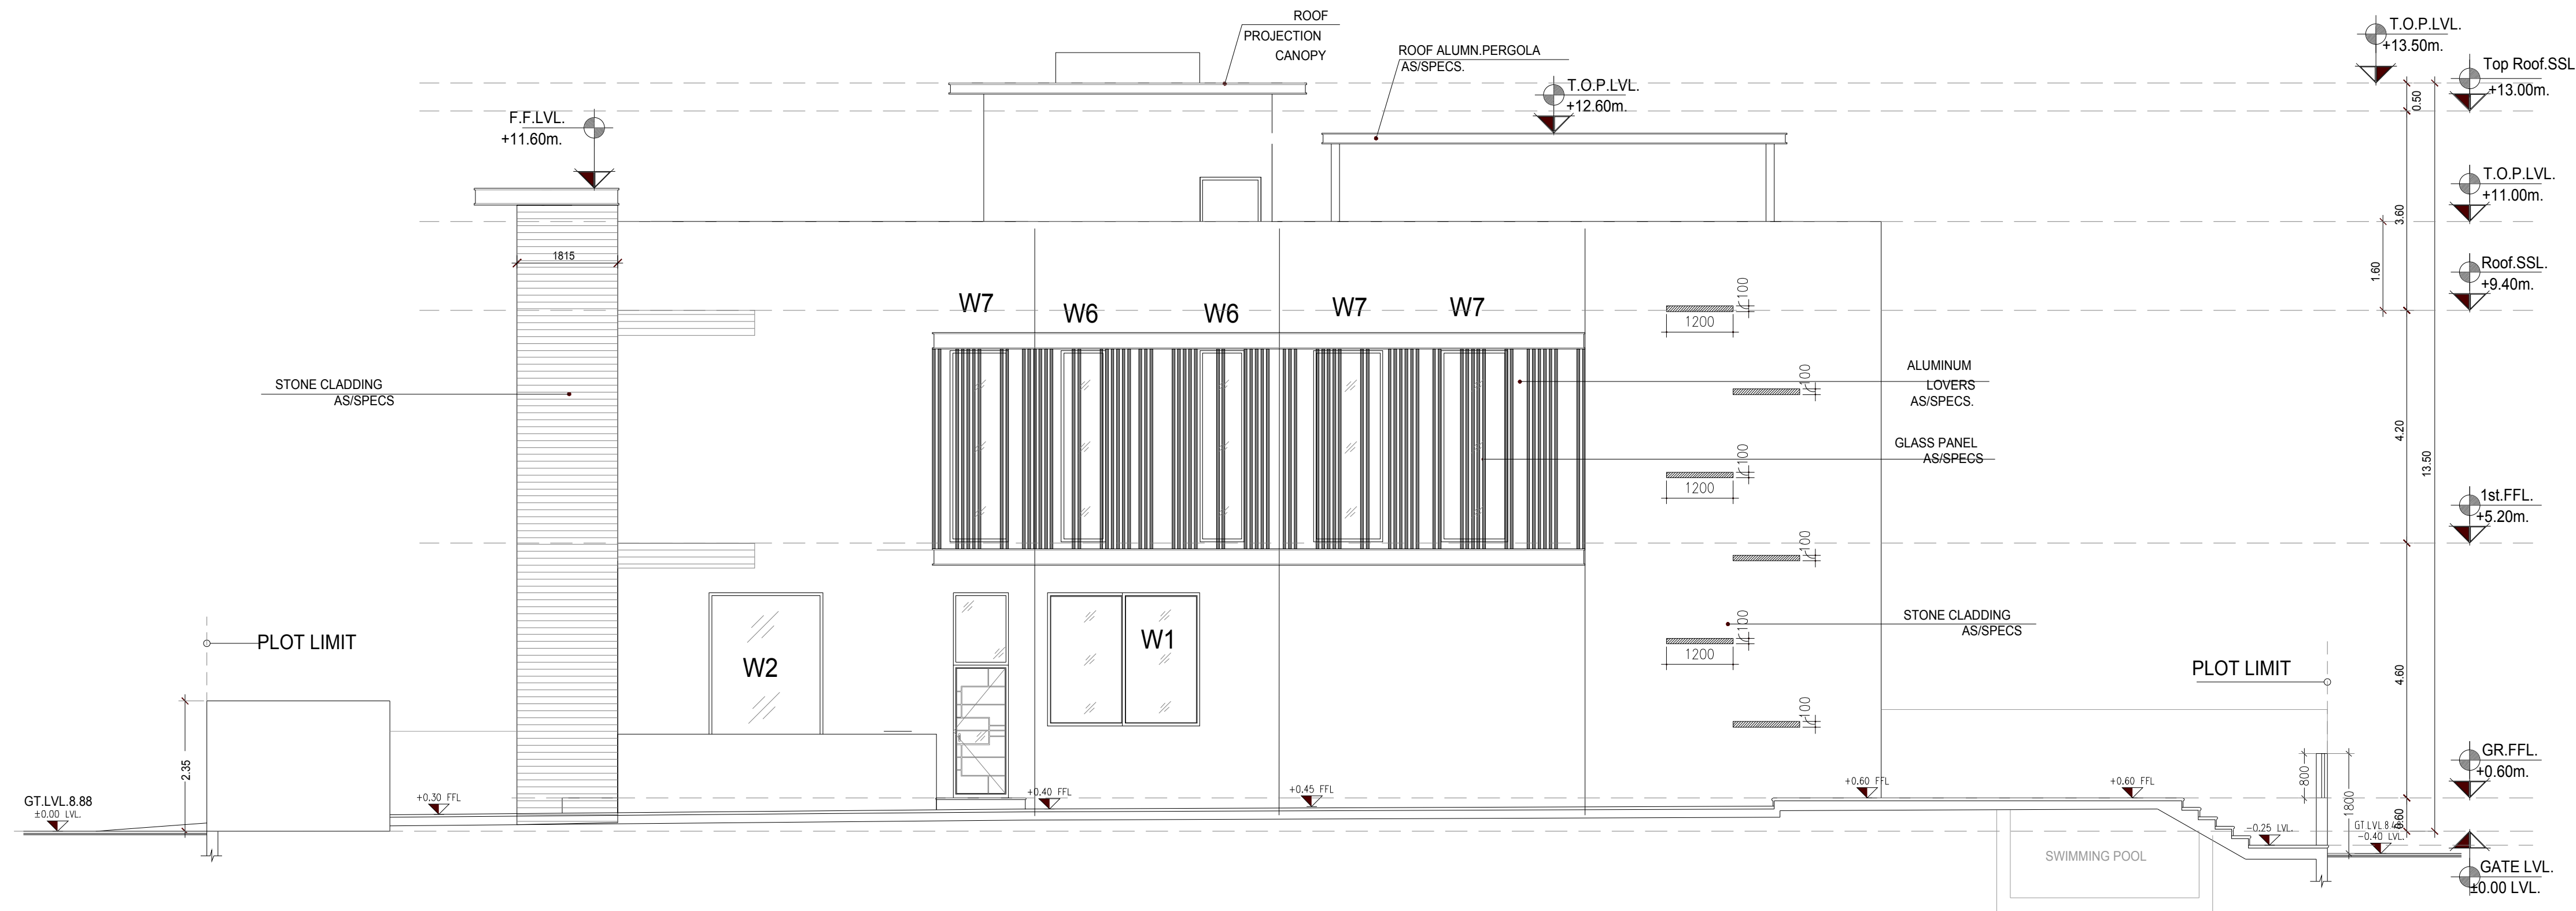


RIGHT ELEVATION-2

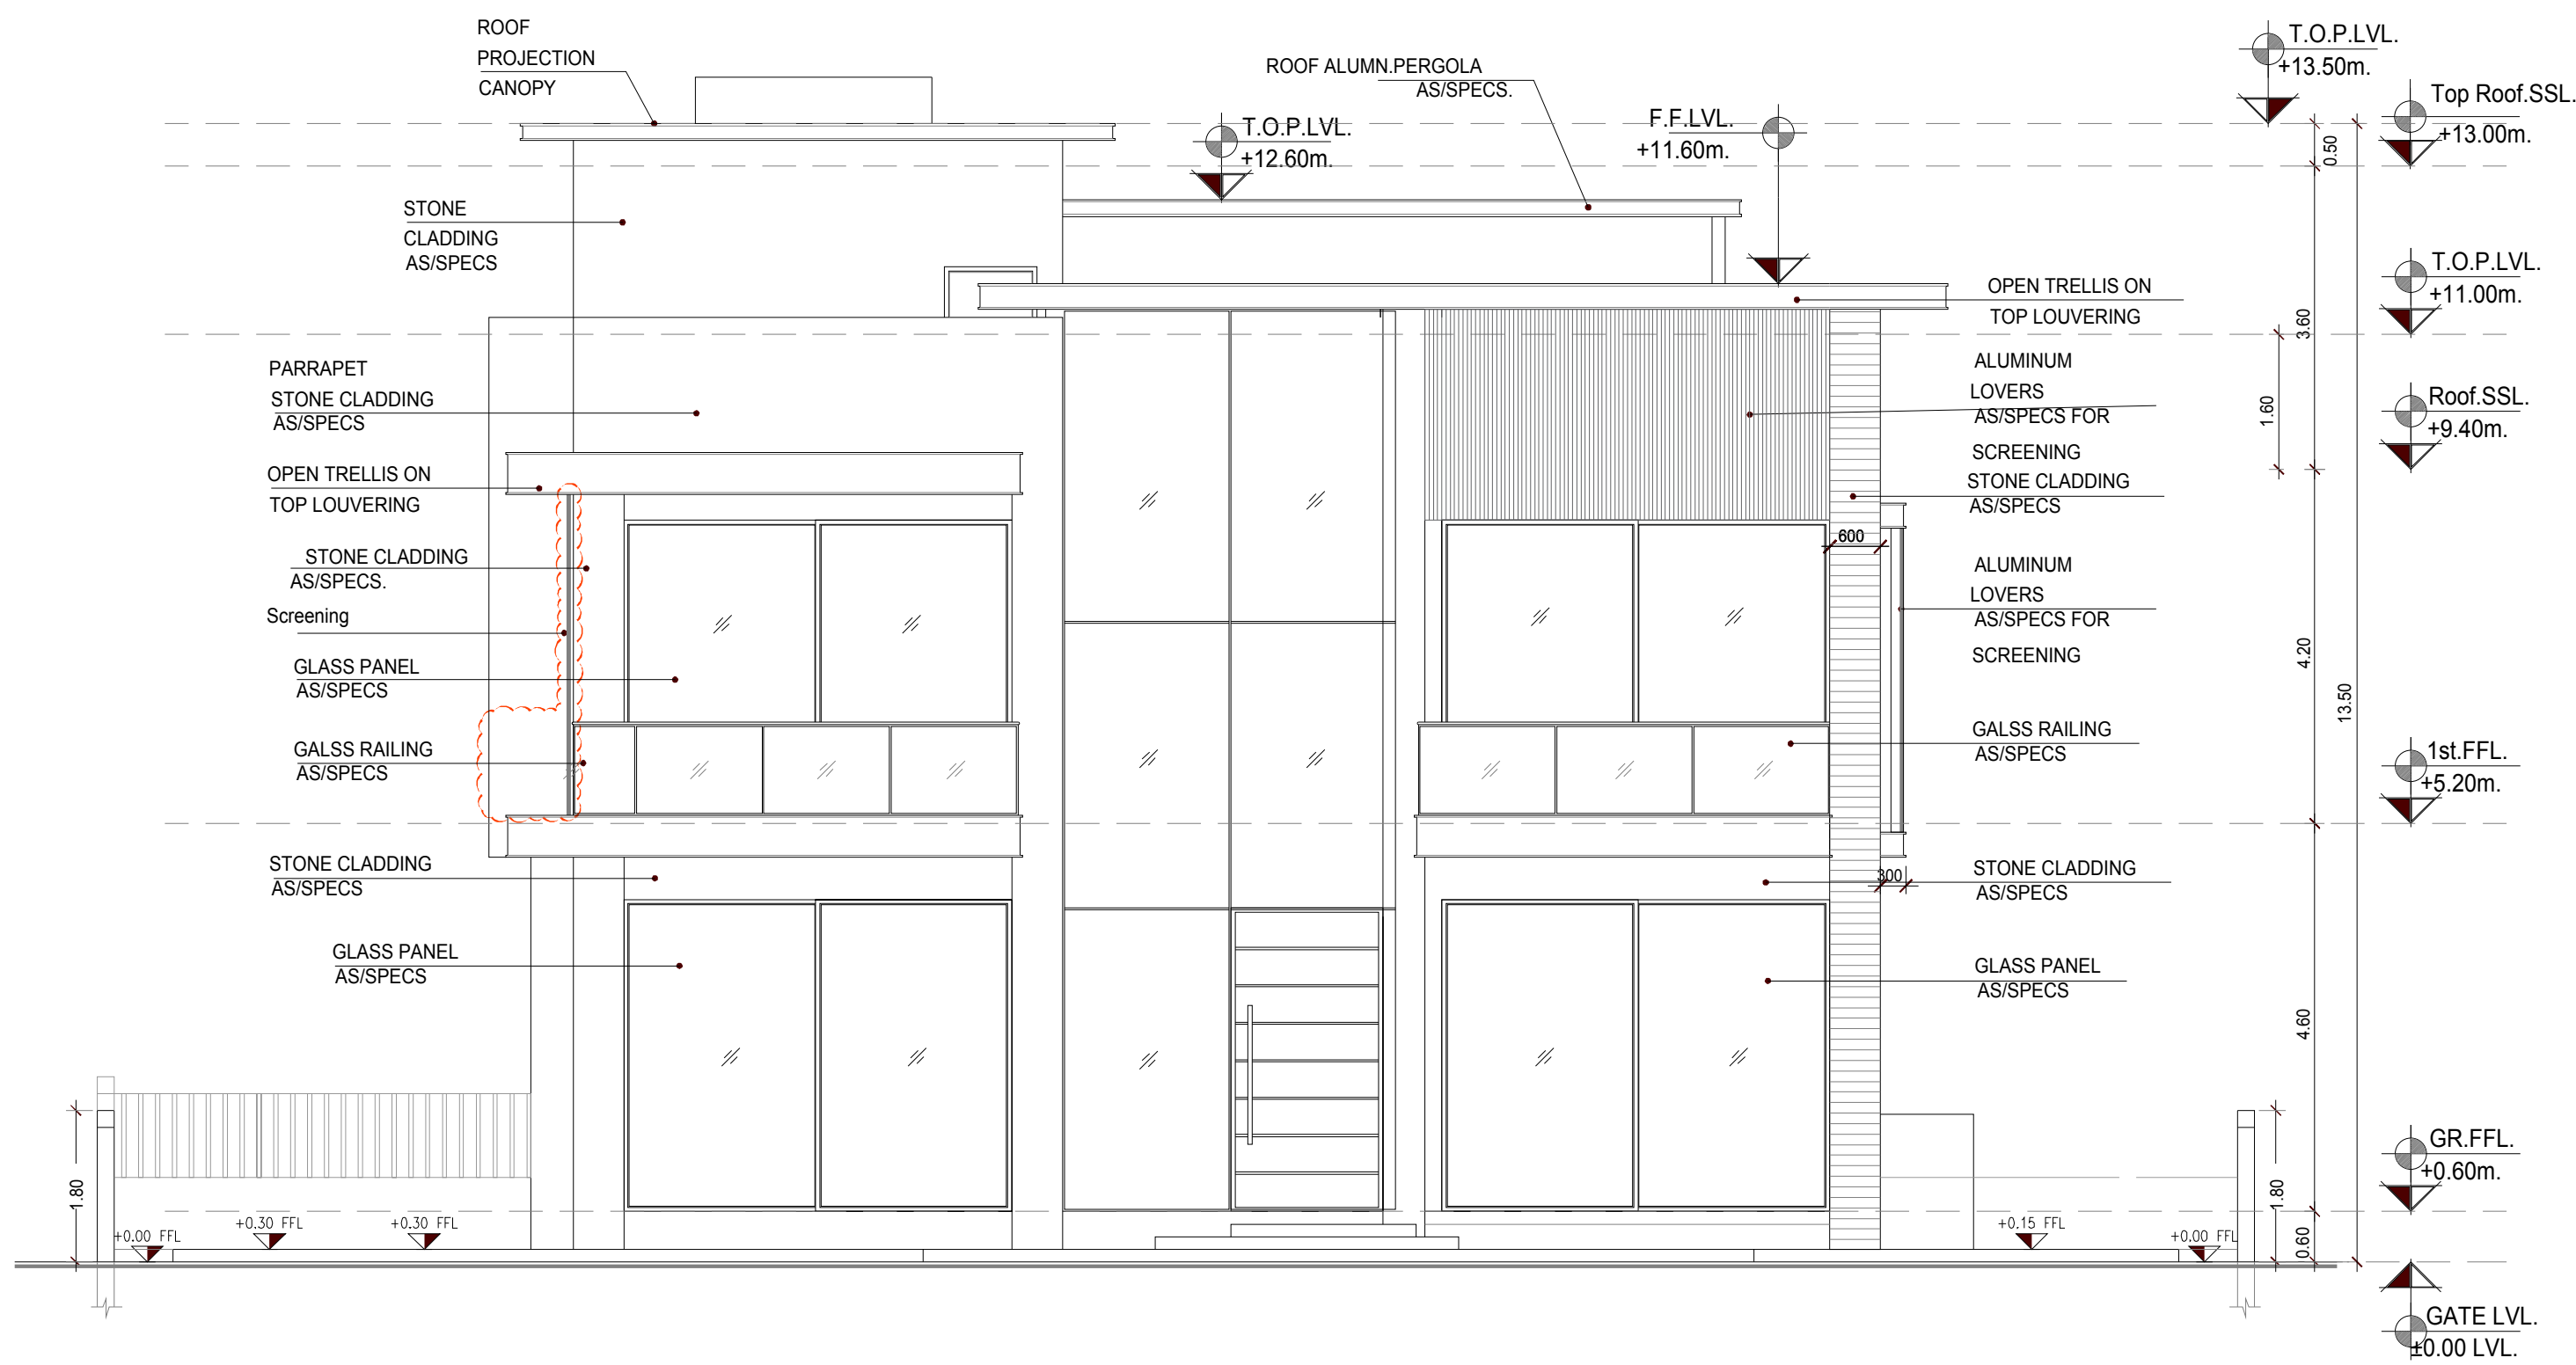


FRONT ELEVATION-1

ELEVATION-1 & ELEVATION- 2

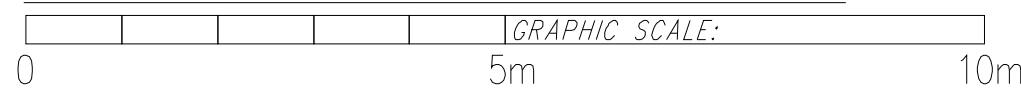

MUNICIPALITY STAMP & APPROVAL

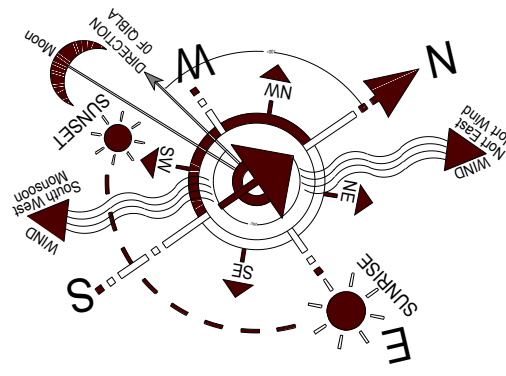

REVISED

REV.	DATE	DESCRIPTION	BY
03.	21/05/2025.	AS BUILT	
02.	17/11/2023.	REVISION [BALCONY EXTENSION]	RAJ.
01.	22/09/2023.	REVISION IN BASE.FLR.&STAIR.	RAJ.



PROJECT OWNER:

DUBAI HILLS ESTATE L.L.C.

JOB TITLE :

PRIVATE VILLA (B+G+1)

PLOT NO. / PARCEL ID	BLOCK:
6316632	HADAEQ SHEIKH MOHAMMED BIN RASHID

DRAWING:

ELEVATION'S
FRONT AND RIGHT

TITLE:	JOB NO. :	985.
ARCHITECT :	STRUCTURAL ENGR :	DRAWN :
ENG: ISMAIL H.S.	ENG.SYED AHMED.	RAJ.
SCALE:	DATE:	CHECKED BY :
	MAY /2025.	ENG: INTEQAB
SHEET SIZE :	DRG.NO. : SH.NO. :	REVISION NO. :
A2	A-201A	REV.- 02.



FRONT VIEW



BACK VIEW

MUNICIPALITY STAMP & APPROVAL



THIS DOCUMENT MAY NOT BE REPRODUCED
BY ANY MEANS WITHOUT PRIOR APPROVAL
FROM THE ENGINEERING CONSULTANTS
2. DRAWINGS ARE NOT TO BE SCALED, STATED
DIMENSIONS ONLY ARE TO BE TAKEN.
INCONSISTENCY OR DISCRIPANCY IS
TO BE BROUGHT TO THE ATTENTION OF
THE CONSULTANT
BEFORE THE WORK IS PUT IN HAND.



REVISED

REV.	DATE	DESCRIPTION	BY
03.	21/05/2025.	AS BUILT	
02.	17/11/2023.	REVISION [BALCONY EXTENSION]	RAJ.
01.	22/09/2023.	REVISION IN BASE FLR. & STAIR.	RAJ.



PROJECT OWNER:

DUBAI HILLS ESTATE L.L.C.

JOB TITLE :

PRIVATE VILLA (B+G+1)


PLOT NO. / PARCEL ID	BLOCK:
6316632	HADAO SHEIKH MOHAMMED BIN RASHID

DRAWING:

PERSPECTIVE
FRONT AND BACK

TITLE:
JOB NO. : 985.

ARCHITECT :	STRUCTURAL ENGR :	DRAWN :
ENG: ISMAIL H.S.	ENG.SYED AHMED.	RAJ.
SCALE:	DATE:	CHECKED BY :
	MAY /2025.	ENG: INTEQAB
SHEET SIZE :	DRG.NO. : SH.NO. :	REVISION NO. :
A2	G-101 03	REV.- 02.

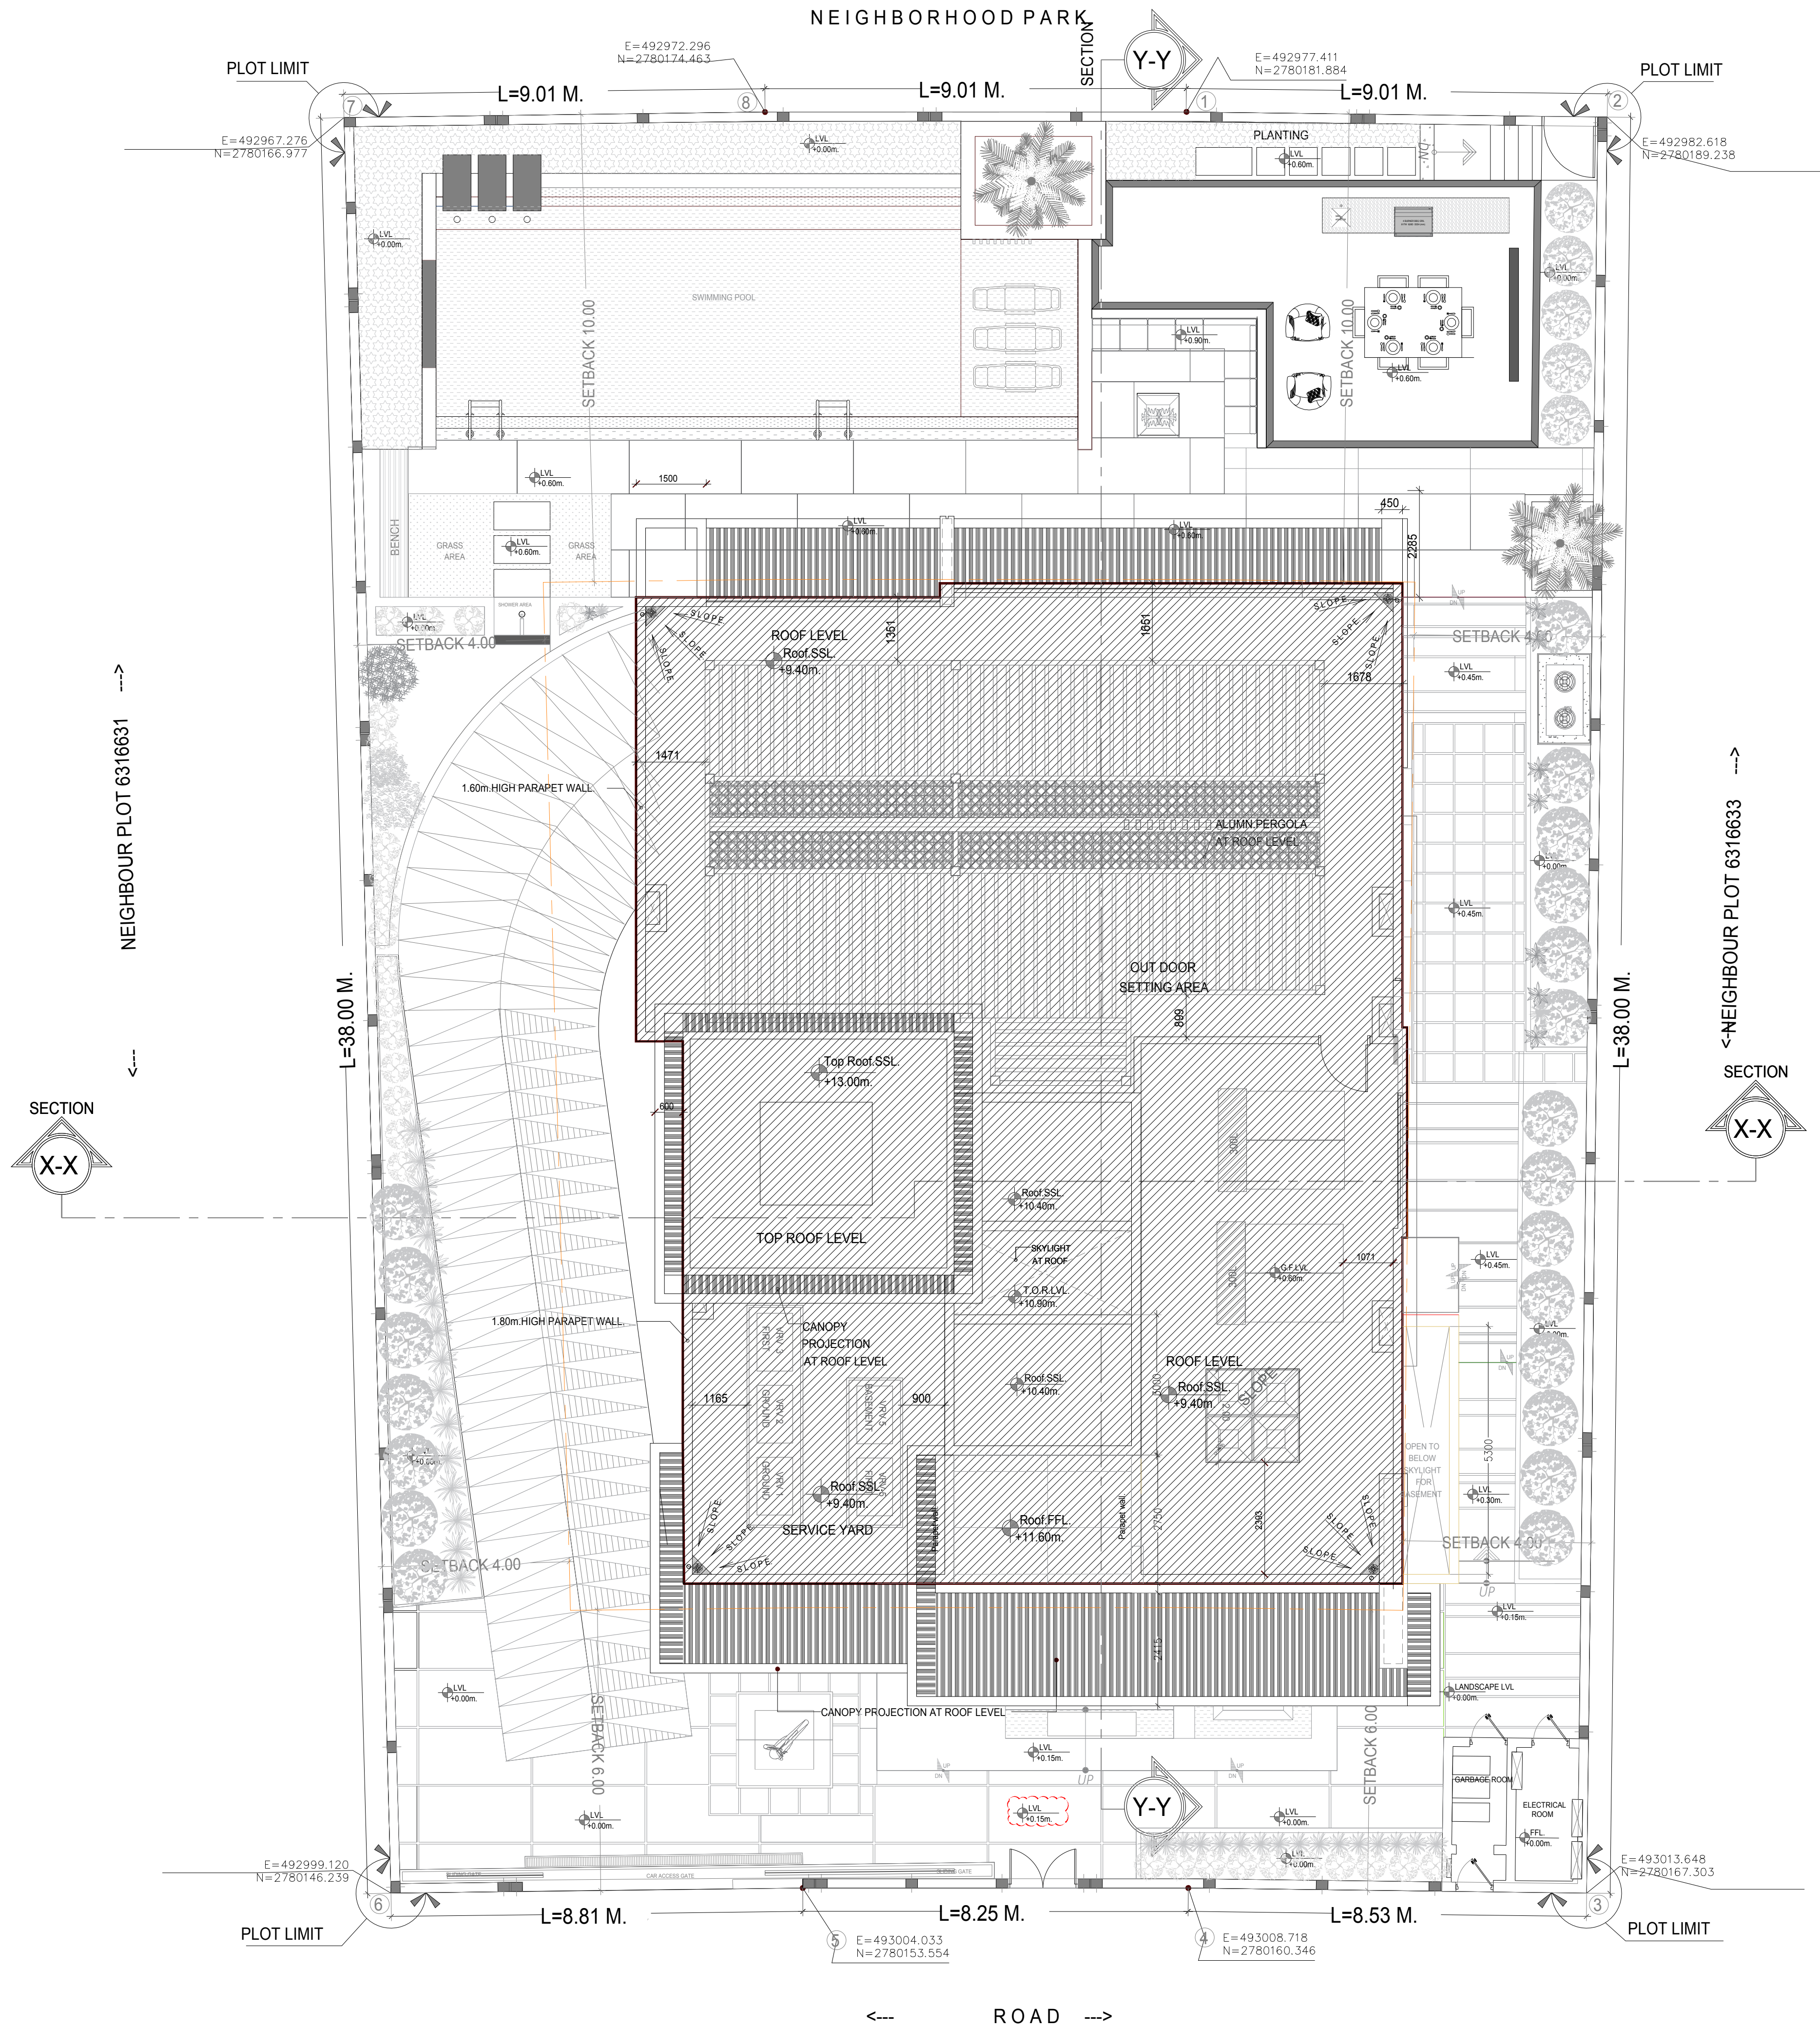


سلطة دبي للتطوير
Dubai Development Authority

02205321 RE.Q. 1938565 29 May 2025

NO OBJECTION

COPY OF APPROVED ELECTRONIC DOCUMENTS ISSUED WITHOUT INCONSISTENCY OR DISCRIPANCY IS SIGNATURE BY DUBAI DEVELOPMENT AUTHORITY

DDA.GOV.AE

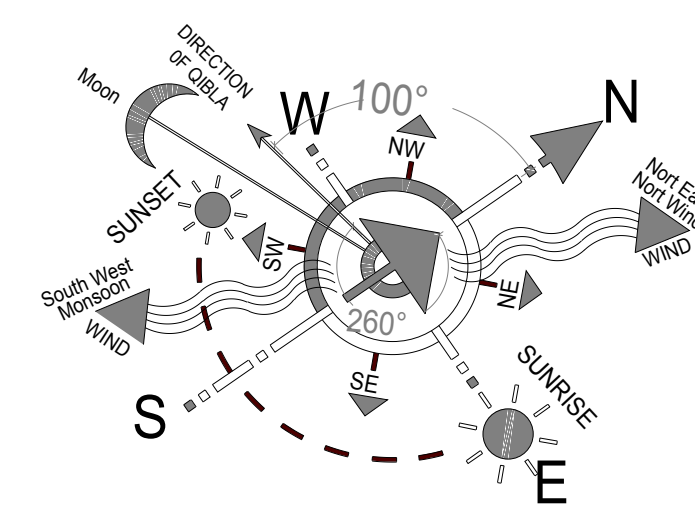

REVISED

REV.	DATE	DESCRIPTION	BY
03.	21/05/2025.	AS BUILT	
02.	17/11/2023.	REVISION [BALCONY EXTENSION]	RAJ.
01.	22/09/2023.	REVISION IN BASE.FLR.&STAIR.	RAJ.

الهندسة
للشؤون الهندسية
RENAISSANCE
ENGINEERING CONSULTANTS
P.O. Box No.124548, Tel: 04-2978142, E-mail: renaissance@em.ae
Mohammed Bin Rashid Al Malkoun Humanitarian & Charity Est. Al Mamzar, Dubai.

PROJECT OWNER:

DUBAI HILLS ESTATE L.L.C.

JOB TITLE :

PRIVATE VILLA (B+G+1)

PLOT NO. / PARCEL ID	BLOCK:
6316632	HADAEQ SHEIKH MOHAMMED BIN RASHID

DRAWING:

SETTING OUT PLAN

TITLE:	JOB NO.:	
985.		
ARCHITECT :	STRUCTURAL ENGR :	DRAWN :
ENG: ISMAIL H.S.	ENG.SYED AHMED.	RAJ.
SCALE:	DATE:	CHECKED BY :
	MAY./2025.	ENG: INTEQAB
SHEET SIZE :	DRG.NO. : SH.NO. :	REVISION NO. :
A2	A-103A	REV.- 02.

COPY OF APPROVED ELECTRONIC DOCUMENTS ISSUED WITHOUT INCONSISTENCY OR DISCREPANCY IS TO BE BROUGHT TO THE ATTENTION OF THE CONSULTANT



03.	21/05/2025.	AS BUILT	
02.	17/11/2023.	REVISION.[BALCONY EXTENSION]	RAJ.
01.	22/09/2023.	REVISION IN BASE.FLR.&STAIR.	RAJ.
REV.	DATE	DESCRIPTION	BY



JOB TITLE :

PLOT NO. / PARCEL ID	
6316632	

DRAWING:

GROUND FLOOR PLAN

TITLE: _____
JOB NO: 985.

ARCHITECT :

ENG: ISMAIL H.S.

SCALE:

100

SHEET SIZE

A2

STRUCTURAL EN

ENG.SYED AHMED.	
-----------------	--

DATE:

MAY./2025.

DRG.NO. : SH.M

A-103A



0 5m 10m