


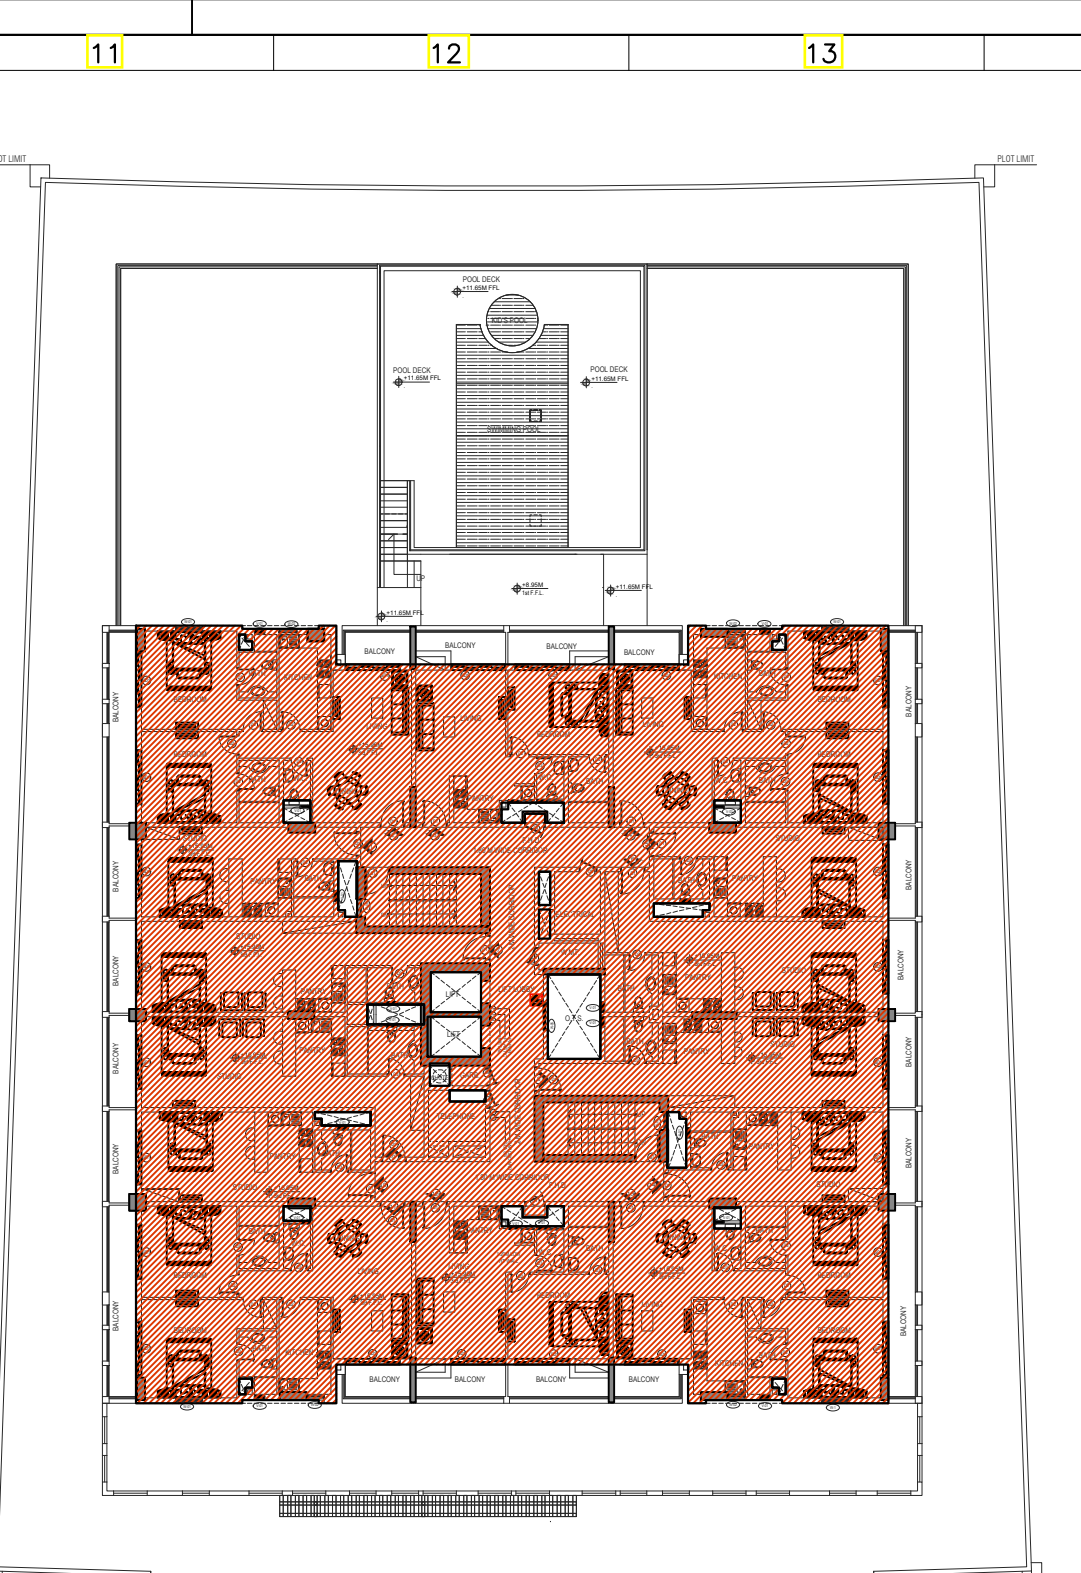
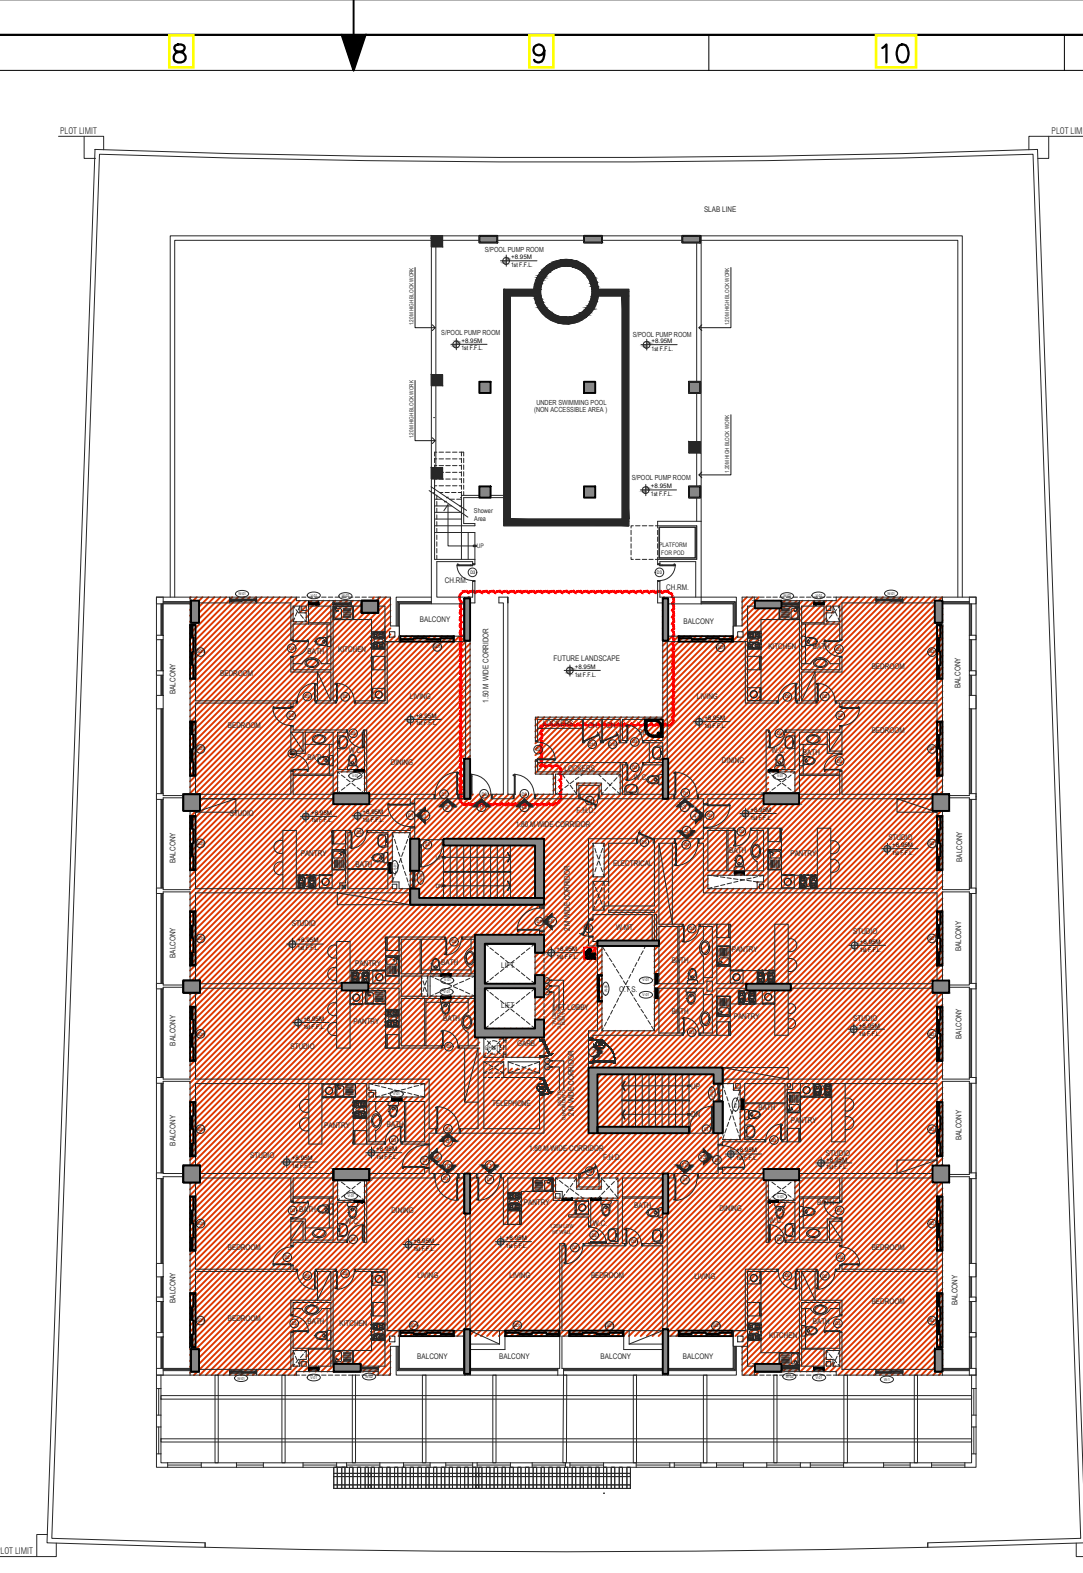


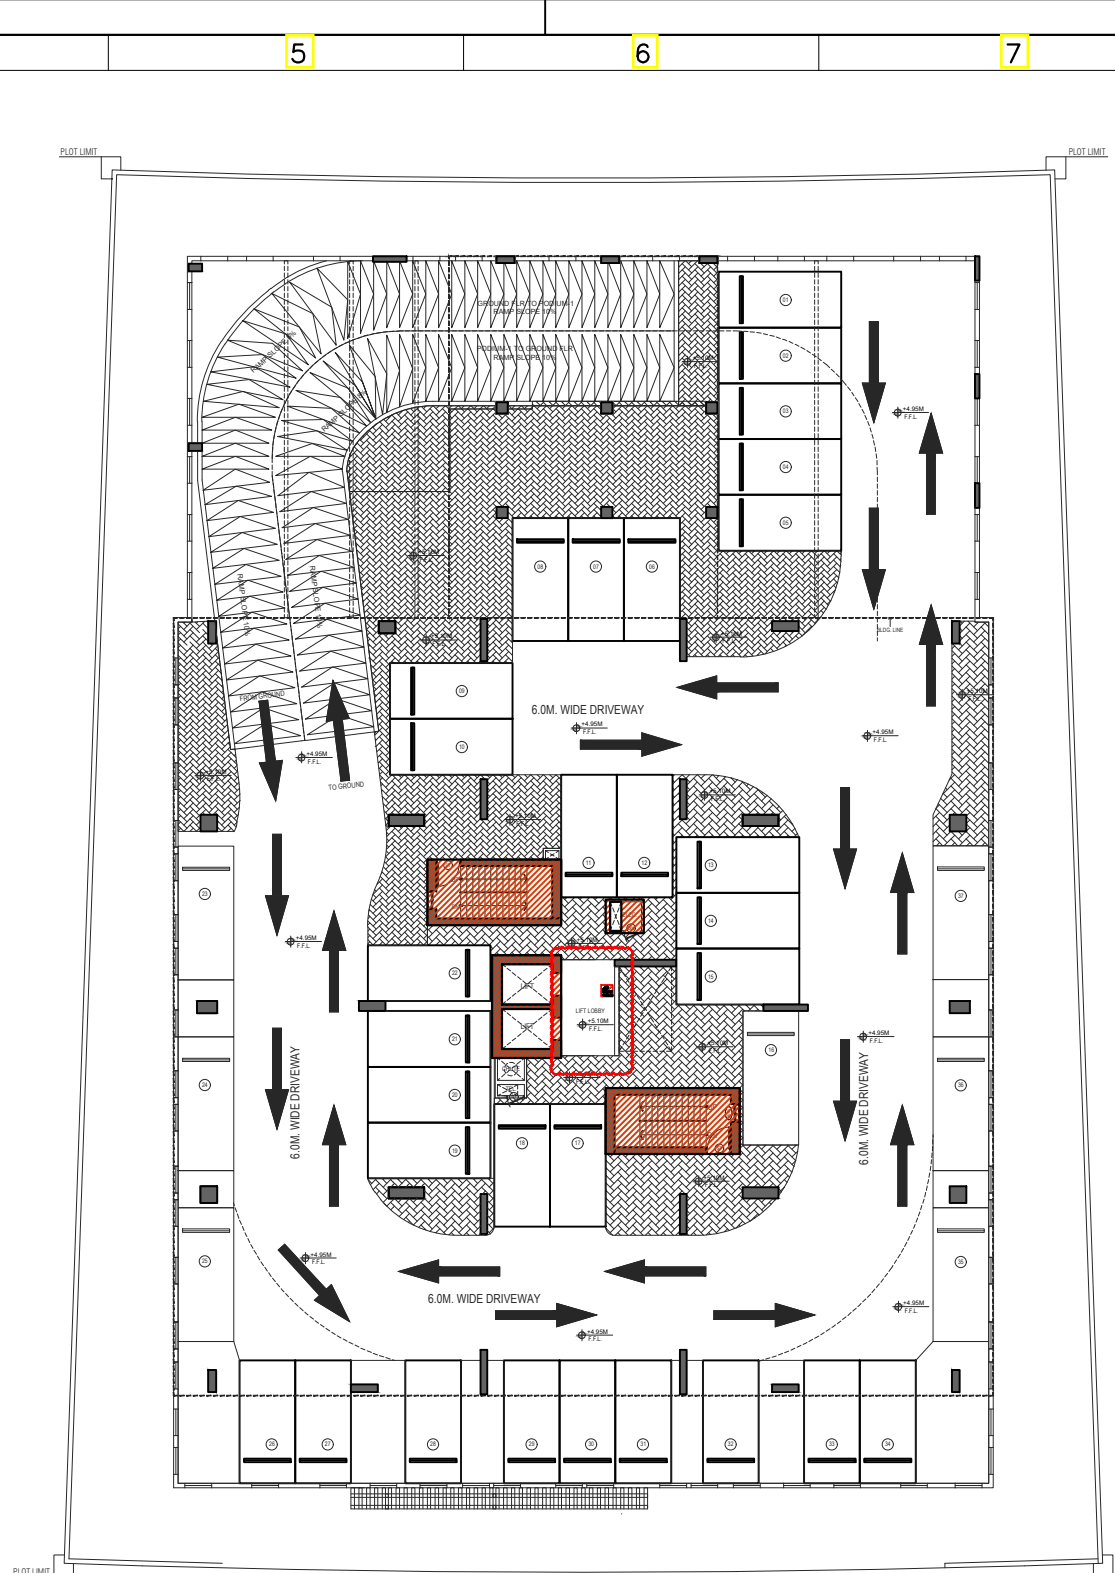


2ND & 3RD FLOOR PLAN

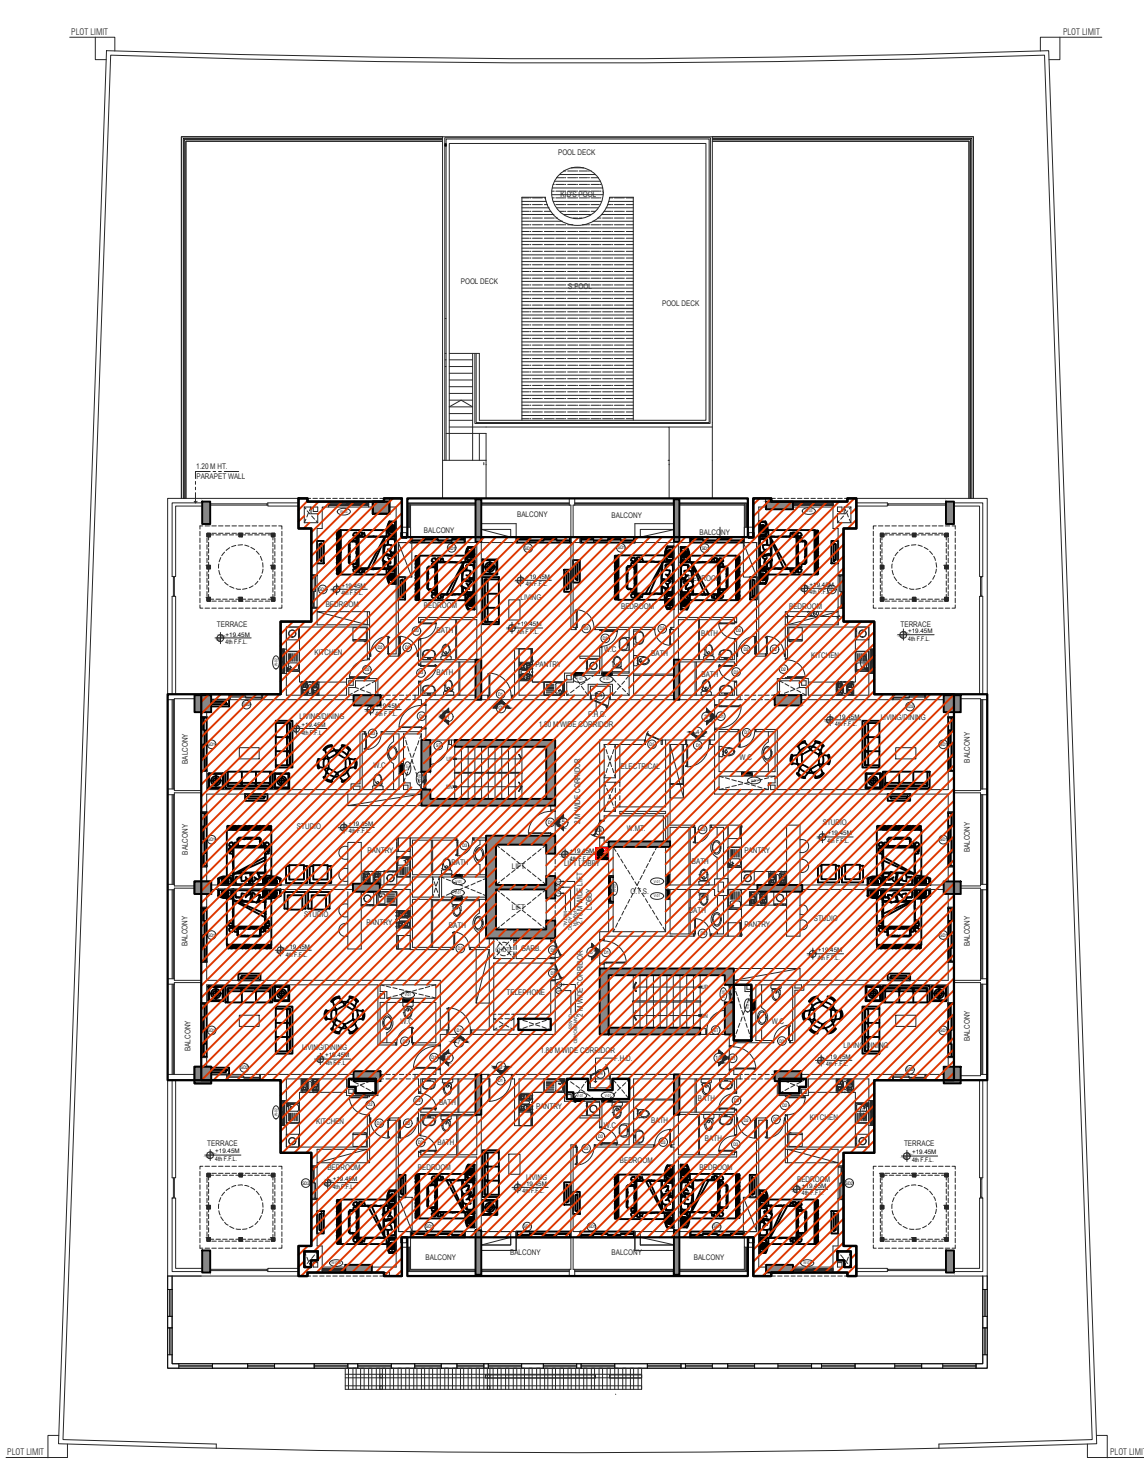


4TH FLOOR

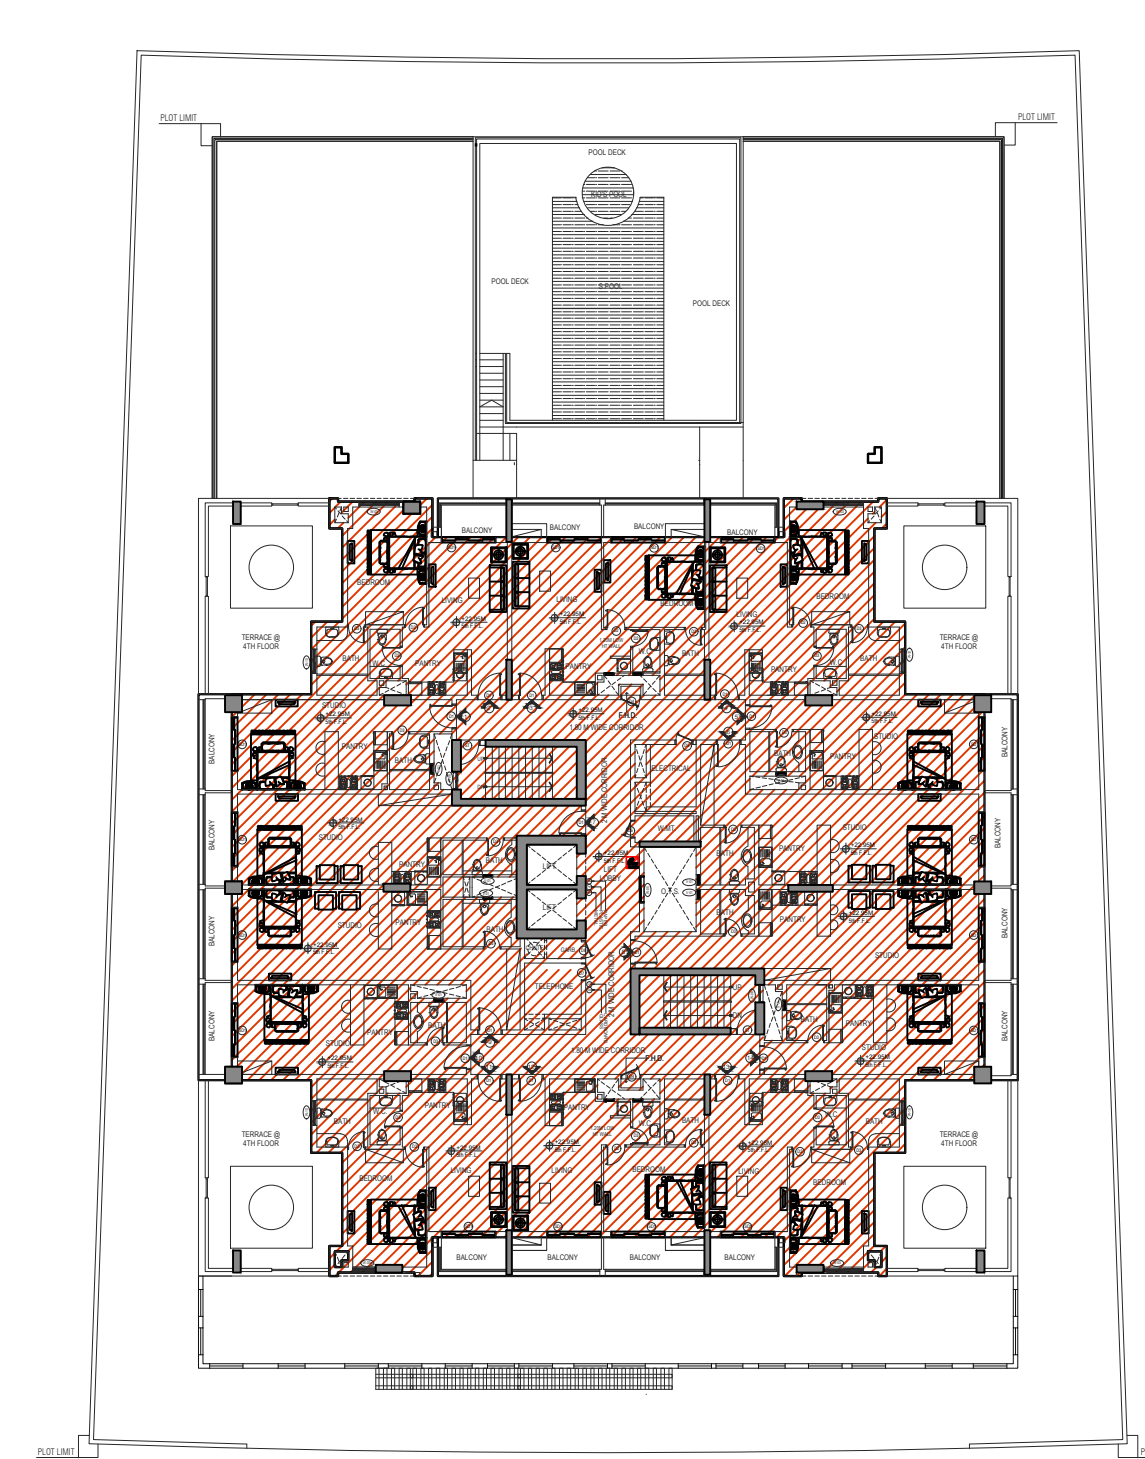


5TH FLOOR

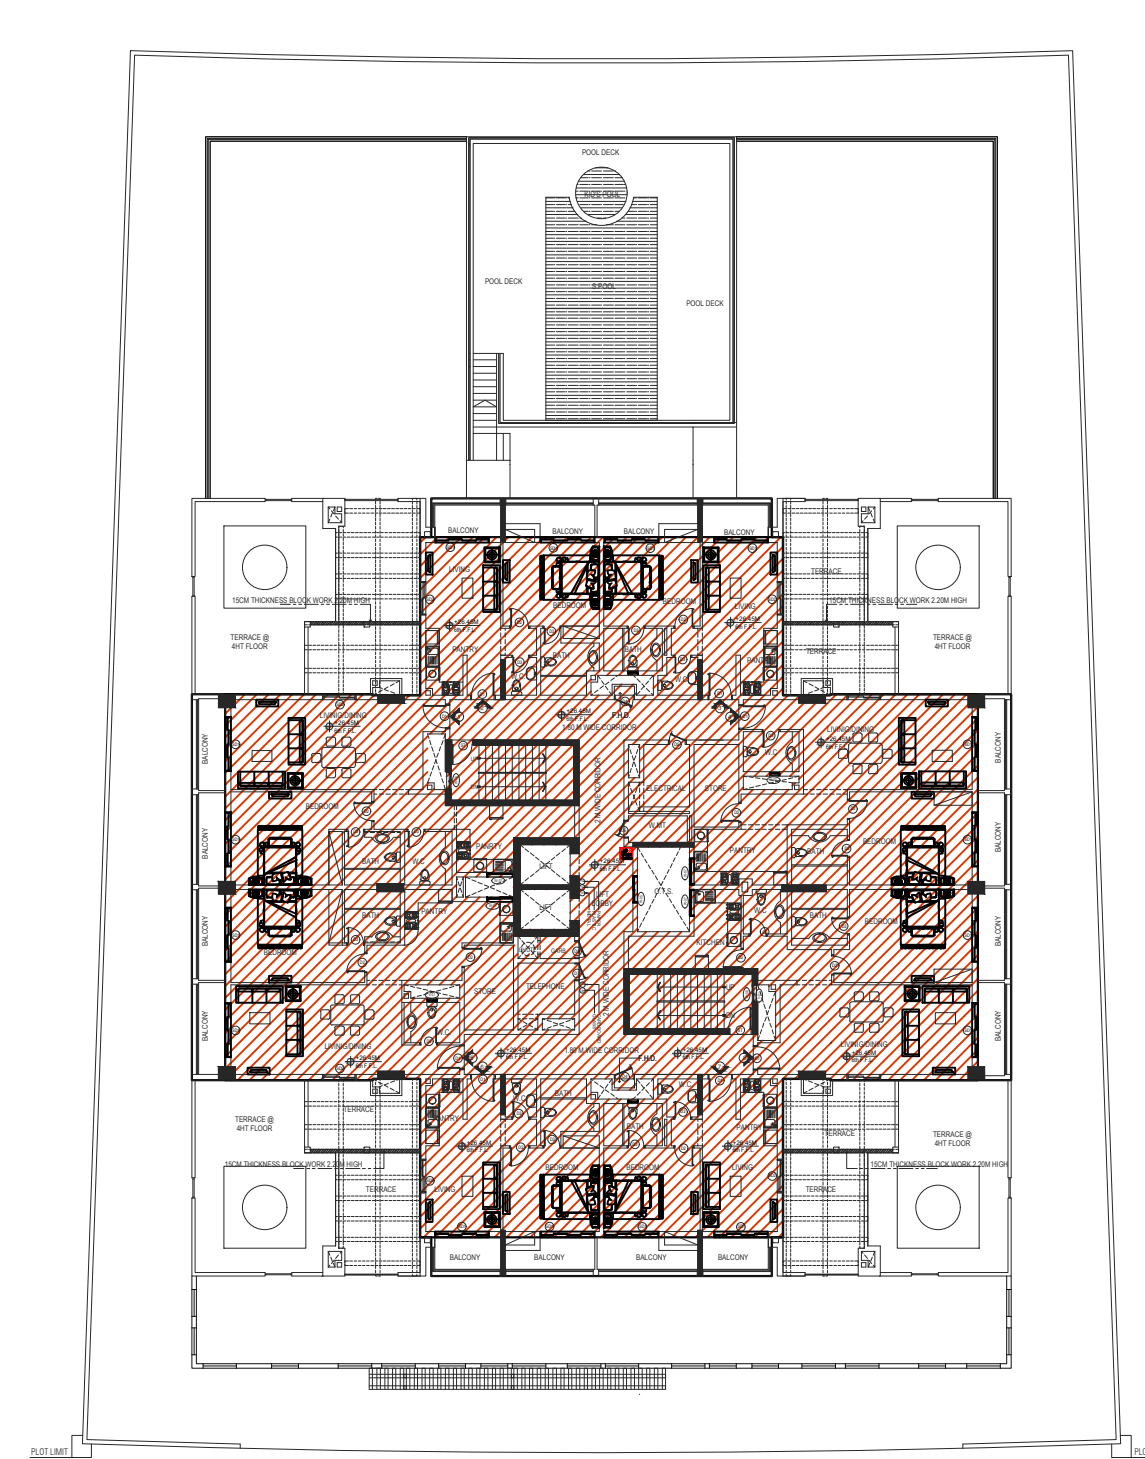

6TH FLOOR

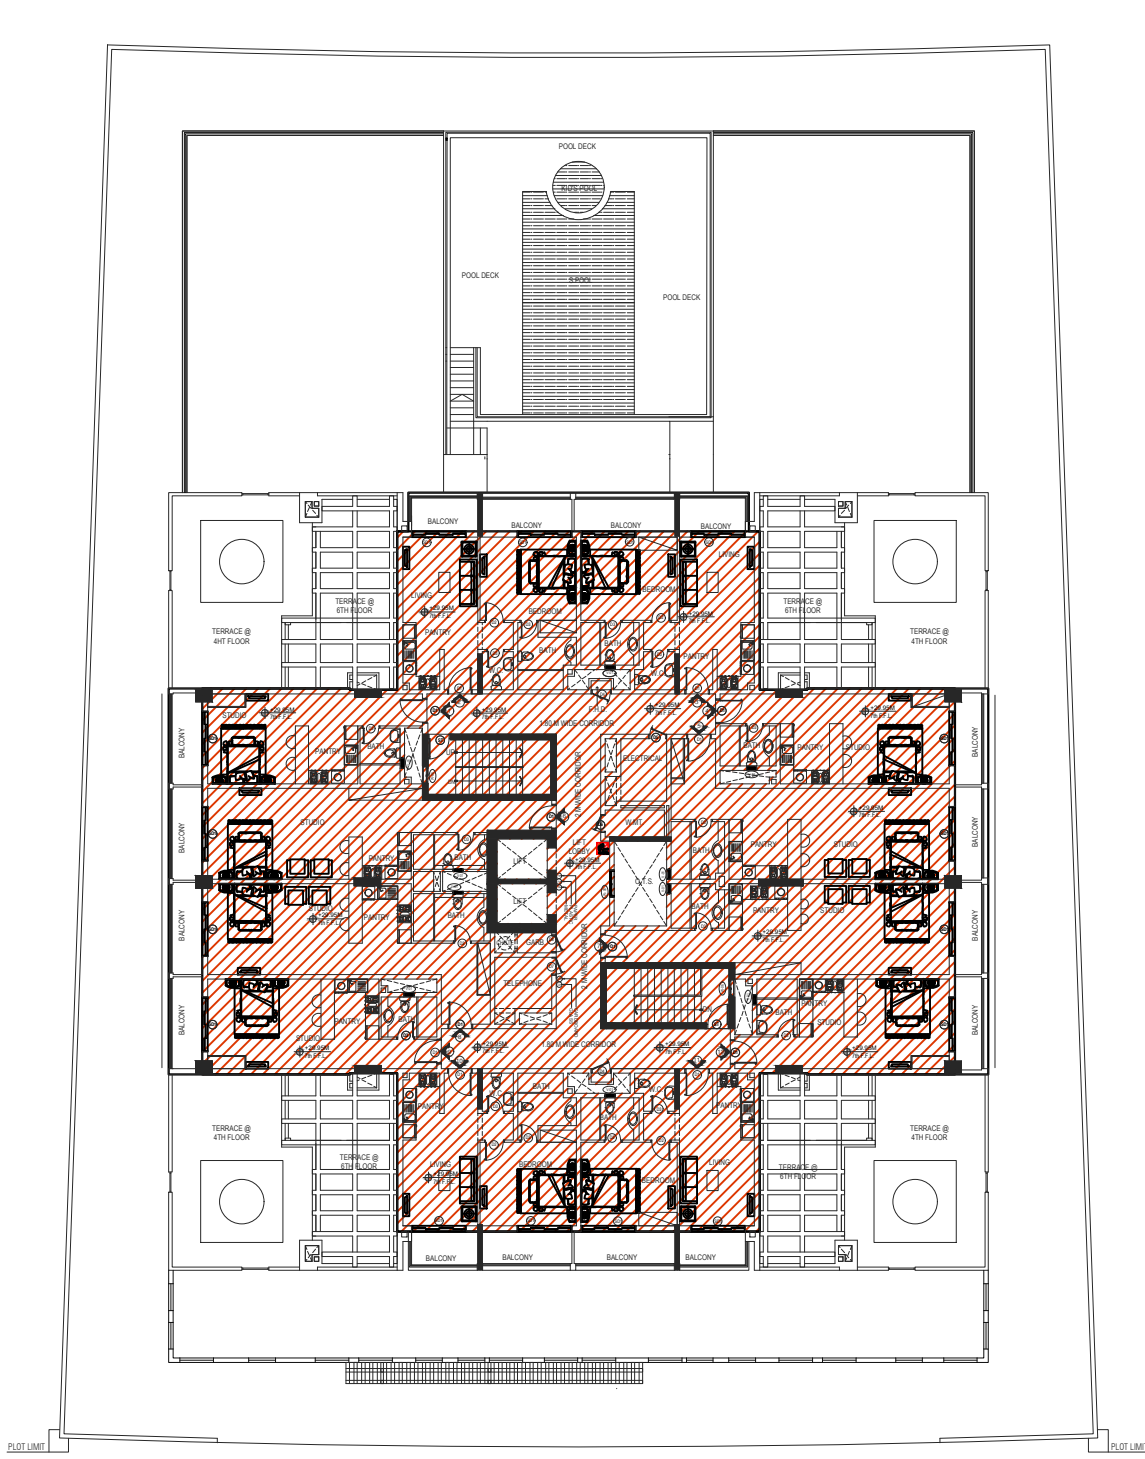

7TH FLOOR

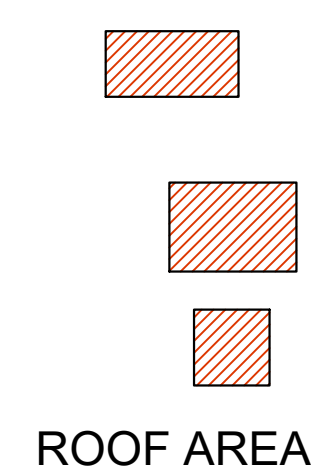

ROOF AREA

GROSS F.A.R. ALLOWED (2773.54X2.2) =		6101.788 Sq.M
PLOT AREA =		2773.54 Sq.M
TOTAL GROSS F.A.R. PROPOSED =		7036.41 Sq.mts
F.A.R. CALCULATIONS		
LEVELS	NO. OF FLOORS	F.A.R. Sq.M
GROUND FLOOR LEVEL	1	307.85 Sq.mts
PODIUM FLOOR LEVEL	1	43.45 Sq.mts
1st FLOOR	1	1039.00 Sq.mts
2nd & 3rd FLOOR	2	(1084.02X2) = 2168.04 Sq.mts
4th & 5th FLOOR	2	(931.85X2) = 1863.70 Sq.mts
6th & 7th FLOOR	2	(781.23X2) = 1562.46 Sq.mts
ROOF	1	51.91 Sq.mts
TOTAL GROSS F.A.R. PROPOSED		7036.41 Sq.mts
SUMMARY OF ALLOWABLE F.A.R. & PROVIDED F.A.R.		
PLOT AREA	2773.54 SQ.MT	
ALLOWABLE F.A.R.	2773.54 X 2.2 = 6101.78 SQ.MT	
PROVIDED F.A.R.	7036.41 SQ.MT (2.07)	
DIFFERENCE IN AREA	(7036.41) 6101.78 = (934.63 SQ.MT EXTRA F.A.R. PROVIDED)	

GENERAL NOTES

- THIS DRAWING IS THE PROPERTY OF :
na architects engineering consultancy
P.O.Box 237347, DUBAI.
IT IS FORBIDDEN TO PRODUCE IT'S CONTENTS IN ANY FORM, EXCEPT FOR THE INTENDED PURPOSE.
- THIS DRAWING IS NOT TO BE SCALED. THE STATED DIMENSIONS ONLY ARE TO BE CONSIDERED.
- THE DISCREPANCIES ARE TO BE BROUGHT TO THE ATTENTION AND RESOLVED BY NA ARCHITECTS ENGINEERING CONSULTANCY BEFORE COMMENCEMENT OF ANY WORK.
- ALWAYS FOLLOWED WRITTEN DIMENSION.

LEGEND

KEY PLAN

AS REVISED

CONTRACTORS REPRESENTATIVES	DATE	INITIALS
CM / PROJECT ENGINEER		
ARCHITECT		
STRUCTURAL ENGINEER		

SUBCONTRACTORS REPRESENTATIVES	DATE	INITIALS
MEP. COORDINATOR		
MECHANICAL ENGINEER		
ELECTRICAL ENGINEER		

PROJECT:

RESIDENTIAL BUILDING
G+1P+7+ROOF

REVIEW STATUS: ☐ A ☐ B ☐ C ☐ D

DATE REVIEWED: _____

REVIEWED BY: _____

DATE: _____

Rev	Date	Description	Drawn	Checked
AB	05/11/2019	AS BUILT DRAWING SUBMISSION	RCF	Engr. Hazem
AB	02/11/2019	AS BUILT DRAWING SUBMISSION	RCF	Engr. Hazem

CLIENT :
MR. MASOOD ABDULLA MOHD
ABDULAZIZ AL ZAROONI


LOCATION: IC- PHASE 3 PLOT No. IC3-H-40

PRINCIPAL CONSULTANT:
NA ARCHITECTS **ان ايه اركيكتس للاستشارات الهندسية**
NA ARCHITECTS ENGINEERING CONSULTANCY
OFFICE 2601 - THE EXCHANGE TOWER
BUSINESS BAY - DUBAI - U.A.E
TEL: 04-2777820 P.O.BOX: 237347
WWW.NAARCHITECTS.NET

MAIN CONTRACTOR :
MC **ALMABNA CONTRACTING COMPANY**
SUB CONTRACTOR :
MC **ALMABNA CONTRACTING COMPANY**

DRAWING TITLE :
PARKING & GAR. CALCULATION-4

DRAWN BY: RCF	JOB NO: P-10	DATE: 05.11.2019
CHECKED BY: Engr. Hazem	SCALE: 1:100	SHEET SIZE: A1
PROJECT NO: NA/IC/B103 NA/IC/B103/15	SHOP DRAWING NO:	REV: AB

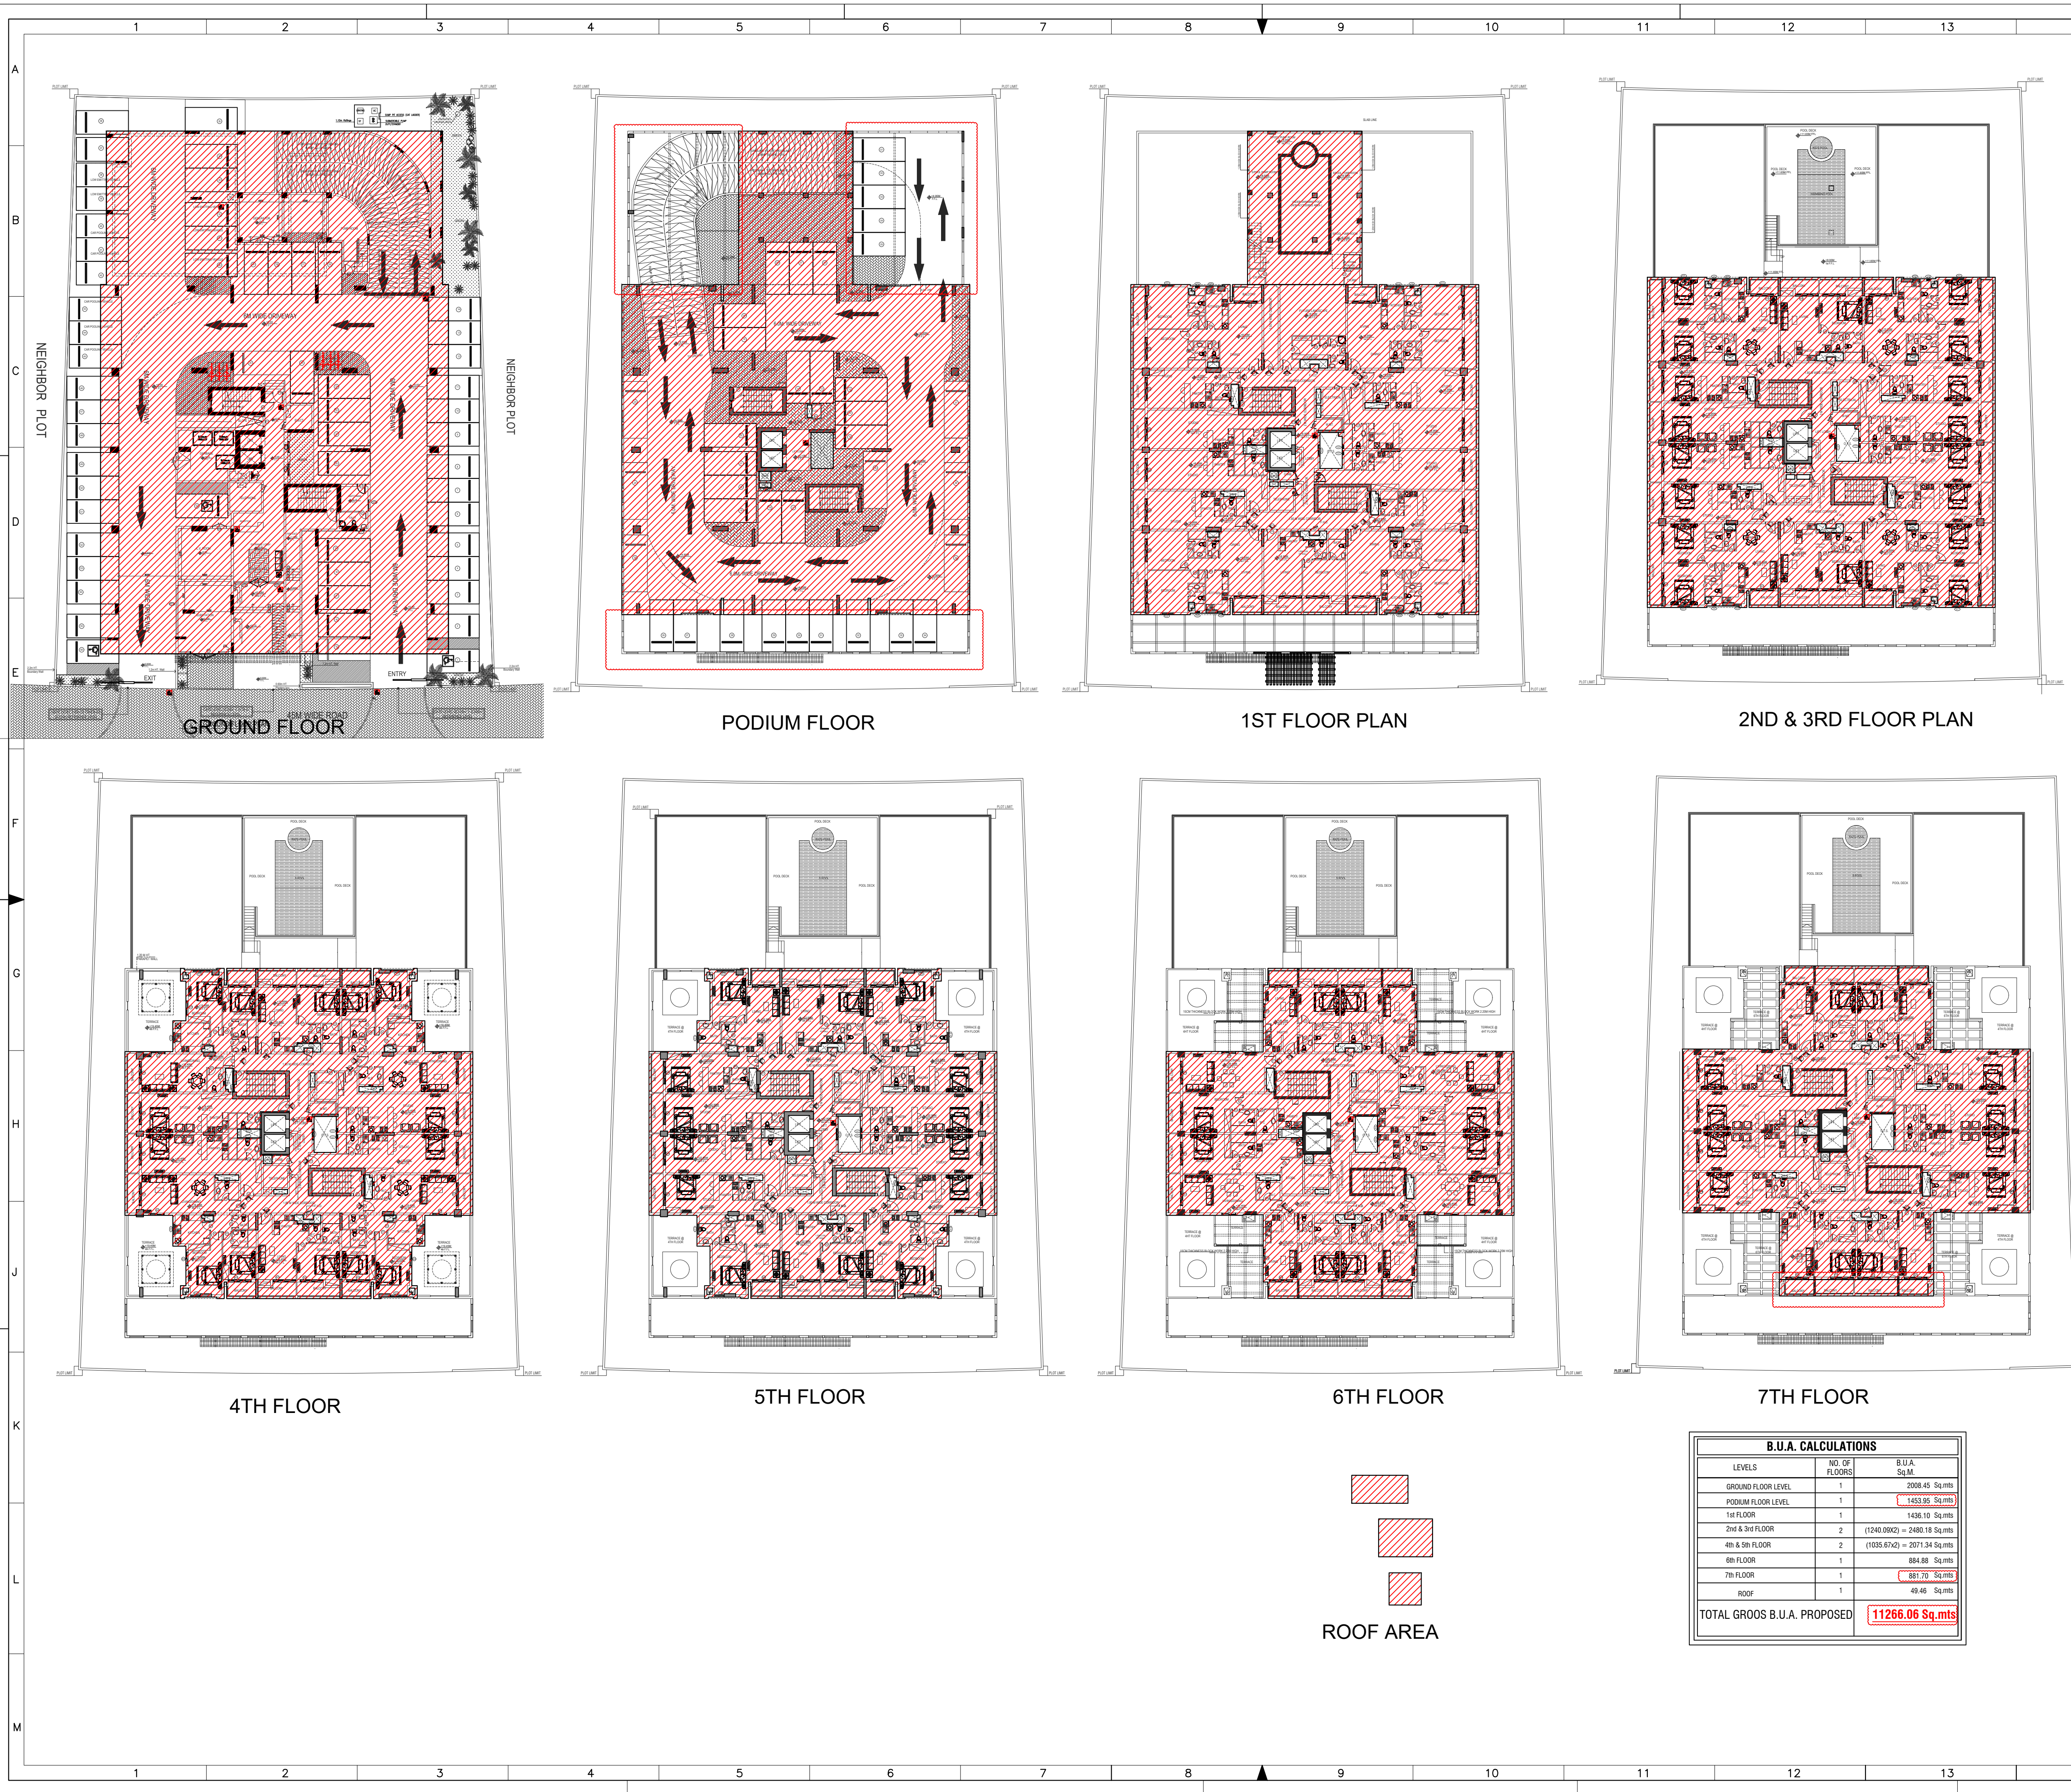

- GENERAL NOTES
1. THIS DRAWING IS THE PROPERTY OF :
na architects engineering consultancy
P.O.Box 237347, DUBAI.
IT IS FORBIDDEN TO PRODUCE IT'S CONTENTS IN ANY FORM, EXCEPT FOR THE INTENDED PURPOSE.
 2. THIS DRAWING IS NOT TO BE SCALED. THE STATED DIMENSIONS ONLY ARE TO BE CONSIDERED.
 3. THE DISCREPANCIES ARE TO BE BROUGHT TO THE ATTENTION AND RESOLVED BY NA ARCHITECTS ENGINEERING CONSULTANCY BEFORE COMMENCEMENT OF ANY WORK.
 4. ALWAYS FOLLOWED WRITTEN DIMENSION.

LEGEND

KEY PLAN

AS REVISED

CONTRACTORS REPRESENTATIVES	DATE	INITIALS
CM / PROJECT ENGINEER		
ARCHITECT		
STRUCTURAL ENGINEER		
SUBCONTRACTORS REPRESENTATIVES	DATE	INITIALS
MEP. COORDINATOR		
MECHANICAL ENGINEER		
ELECTRICAL ENGINEER		

PROJECT:

RESIDENTIAL BUILDING
G+1P+7+ROOF

REVIEW STATUS ☐ A ☐ B ☐ C ☐ D

DATE REVIEWED

REVIEWED BY

DATE:

Rev	Date	Description	Drawn	Checked
AB	05/11/2019	AS BUILT DRAWING SUBMISSION	RCF	Engr. Hazem
AB	02/11/2019	AS BUILT DRAWING SUBMISSION	RCF	Engr. Hazem

CLIENT :

MR. MASOOD ABDULLA MOHD
ABDULAZIZ AL ZAROONI

LOCATION	PLOT No.
IC- PHASE 3	IC3-H-40

PRINCIPAL CONSULTANT:

NA **نا ايه ار ككتس الاستشارات الهندسية**
NA ARCHITECTS ENGINEERING CONSULTANCY

OFFICE 2601 - THE EXCHANGE TOWER
BUSINESS BAY - DUBAI - U.A.E
TEL: 04-2777820 P.O.BOX: 237347
WWW.NAARCHITECTS.NET

MAIN CONTRACTOR :

MC **ALMABNA CONTRACTING COMPANY**
P.O.BOX: 233146

SUB CONTRACTOR :

MC **ALMABNA CONTRACTING COMPANY**
P.O.BOX: 233146

DRAWING TITLE :

BUILT UP AREA CALCULATION

DRAWN BY: RCF	JOB NO: P-10	DATE: 05.11.2019
CHECKED BY: Engr. Hazem	SCALE: 1:100	SHEET SIZE: A1
PROJECT NO: NA/IC/B103 NA/IC/B103/15	SHOP DRAWING NO:	REV: AB

FLATS SCHEDULE			
LEVELS	2BEDROOM	1BEDROOM	STUDIO
1st FLOOR	4 no's	1 no.	8 no's
2nd FLOOR	4 no's	2 no's	8 no's
3rd FLOOR	4 no's	2 no's	8 no's
4th FLOOR	4 no's	2 no's	4 no's
5th FLOOR	-----	6 no's	8 no's
6th FLOOR	-----	8 no's	-----
7th FLOOR	-----	4 no's	8 no's
TOTAL FLATS PROVIDED	16 no's	25 no's	44 no's

TOTAL NO. OF FLATS - 85

PARKING CALCULATIONS-REQUIRED

UNIT TYPE	TOTAL UNIT	REGULATIONS	TOTAL
2 BED ROOM	16 NOS.	UNIT/1.5 PARKING	24 NOS.
1 BED ROOM	25 NOS.	UNIT/1 PARKING	25 NOS.
STUDIO'S	44 NOS.	UNIT/1 PARKING	44 NOS.
VISITOR'S	FOR 35 CARS=1 PARKING		03 NOS.

TOTAL 96 NOS.

PARKING CALCULATIONS-PROVIDED

FLOORS	NUMBERS
GROUND	57 NOS
PODIUM	37 NOS

TOTAL 94 NOS. PARKING

POD PARKING 3% = 94X3/100 = 3.00 NOS(REQUIRED) - 3.00 NOS (PROVIDED)

FLATS AREA / FLOOR

LEVELS	AREA IN SQ.M
1st FLOOR	804.12
2nd FLOOR	860.29
3rd FLOOR	860.29
4th FLOOR	717.93
5th FLOOR	711.23
6th FLOOR	717.93
7th FLOOR	573.14
TOTAL FLATS AREA	5244.93 SQ.M 56456.42 SQ.FT

SUMMARY FOR GARBAGE CONTAINER

CALCULATIONS	WEIGHT	NO. OF CONT. REQ.	NO. OF CONT. PROVIDED
(TOTAL COMMERCIAL AREA = / 1000) x12 KG =	NIL		3 No's OF CONTAINER 2.5 CUB. M SIZE
(TOTAL SHOPPING AREA = /1000)x12 KG =	NIL		
(TOTAL RESIDENTIAL AREA = 56817.55 /1000) x 12 KG =	681.81 KG.	3 No's OF CONTAINER 2.5 CUB. M SIZE	
TOTAL WEIGHT	681.81 KG.		

- GENERAL NOTES
- THIS DRAWING IS THE PROPERTY OF :
na architects engineering consultancy
P.O.Box 237347, DUBAI.
IT IS FORBIDDEN TO PRODUCE IT'S CONTENTS IN ANY FORM, EXCEPT FOR THE INTENDED PURPOSE.
 - THIS DRAWING IS NOT TO BE SCALED. THE STATED DIMENSIONS ONLY ARE TO BE CONSIDERED.
 - THE DISCREPANCIES ARE TO BE BROUGHT TO THE ATTENTION AND RESOLVED BY NA ARCHITECTS ENGINEERING CONSULTANCY BEFORE COMMENCEMENT OF ANY WORK.
 - ALWAYS FOLLOWED WRITTEN DIMENSION.

LEGEND

KEY PLAN

AS REVISED

CONTRACTORS REPRESENTATIVES	DATE	INITIALS
CM / PROJECT ENGINEER		
ARCHITECT		
STRUCTURAL ENGINEER		
SUBCONTRACTORS REPRESENTATIVES	DATE	INITIALS
MEP. COORDINATOR		
MECHANICAL ENGINEER		
ELECTRICAL ENGINEER		

PROJECT:

RESIDENTIAL BUILDING
G+1P+7+ROOF

REVIEW STATUS ☐ A ☐ B ☐ C ☐ D

DATE REVIEWED

REVIEWED BY

DATE:

AB	05/11/2019	AS BUILT DRAWING SUBMISSION	RCF	Engr. Hazem
AB	02/11/2019	AS BUILT DRAWING SUBMISSION	RCF	Engr. Hazem
Rev	Date	Description	Drawn	Checked

CLIENT :

MR. MASOOD ABDULLA MOHD
ABDULAZIZ AL ZAROONI

LOCATION	PLOT No.
IC- PHASE 3	IC3-H-40

PRINCIPAL CONSULTANT:

NA ان ايه اركيكتس الاستشارات الهندسية
NA ARCHITECTS ENGINEERING CONSULTANCY
OFFICE 2601 - THE EXCHANGE TOWER
BUSINESS BAY - DUBAI - U.A.E
TEL: 04-2777820 P.O.BOX: 237347
www.naarchitects.net

MAIN CONTRACTOR :

MC ALMABNA CONTRACTING COMPANY
OFFICE 2601 - THE EXCHANGE TOWER
BUSINESS BAY - DUBAI - U.A.E
TEL: 04-2777820 P.O.BOX: 237347


SUB CONTRACTOR :

MC ALMABNA CONTRACTING COMPANY
OFFICE 2601 - THE EXCHANGE TOWER
BUSINESS BAY - DUBAI - U.A.E
TEL: 04-2777820 P.O.BOX: 237347

DRAWING TITLE :

PARKING & GAR. CALCULATION-4

DRAWN BY:	JOB NO:	DATE:
RCF	P-10	05.11.2019
CHECKED BY:	SCALE:	SHEET SIZE:
Engr. Hazem	1:100	A1
PROJECT NO:	SHOP DRAWING NO:	REV:
NA/IC/B103 NA/IC/B103/15		AB

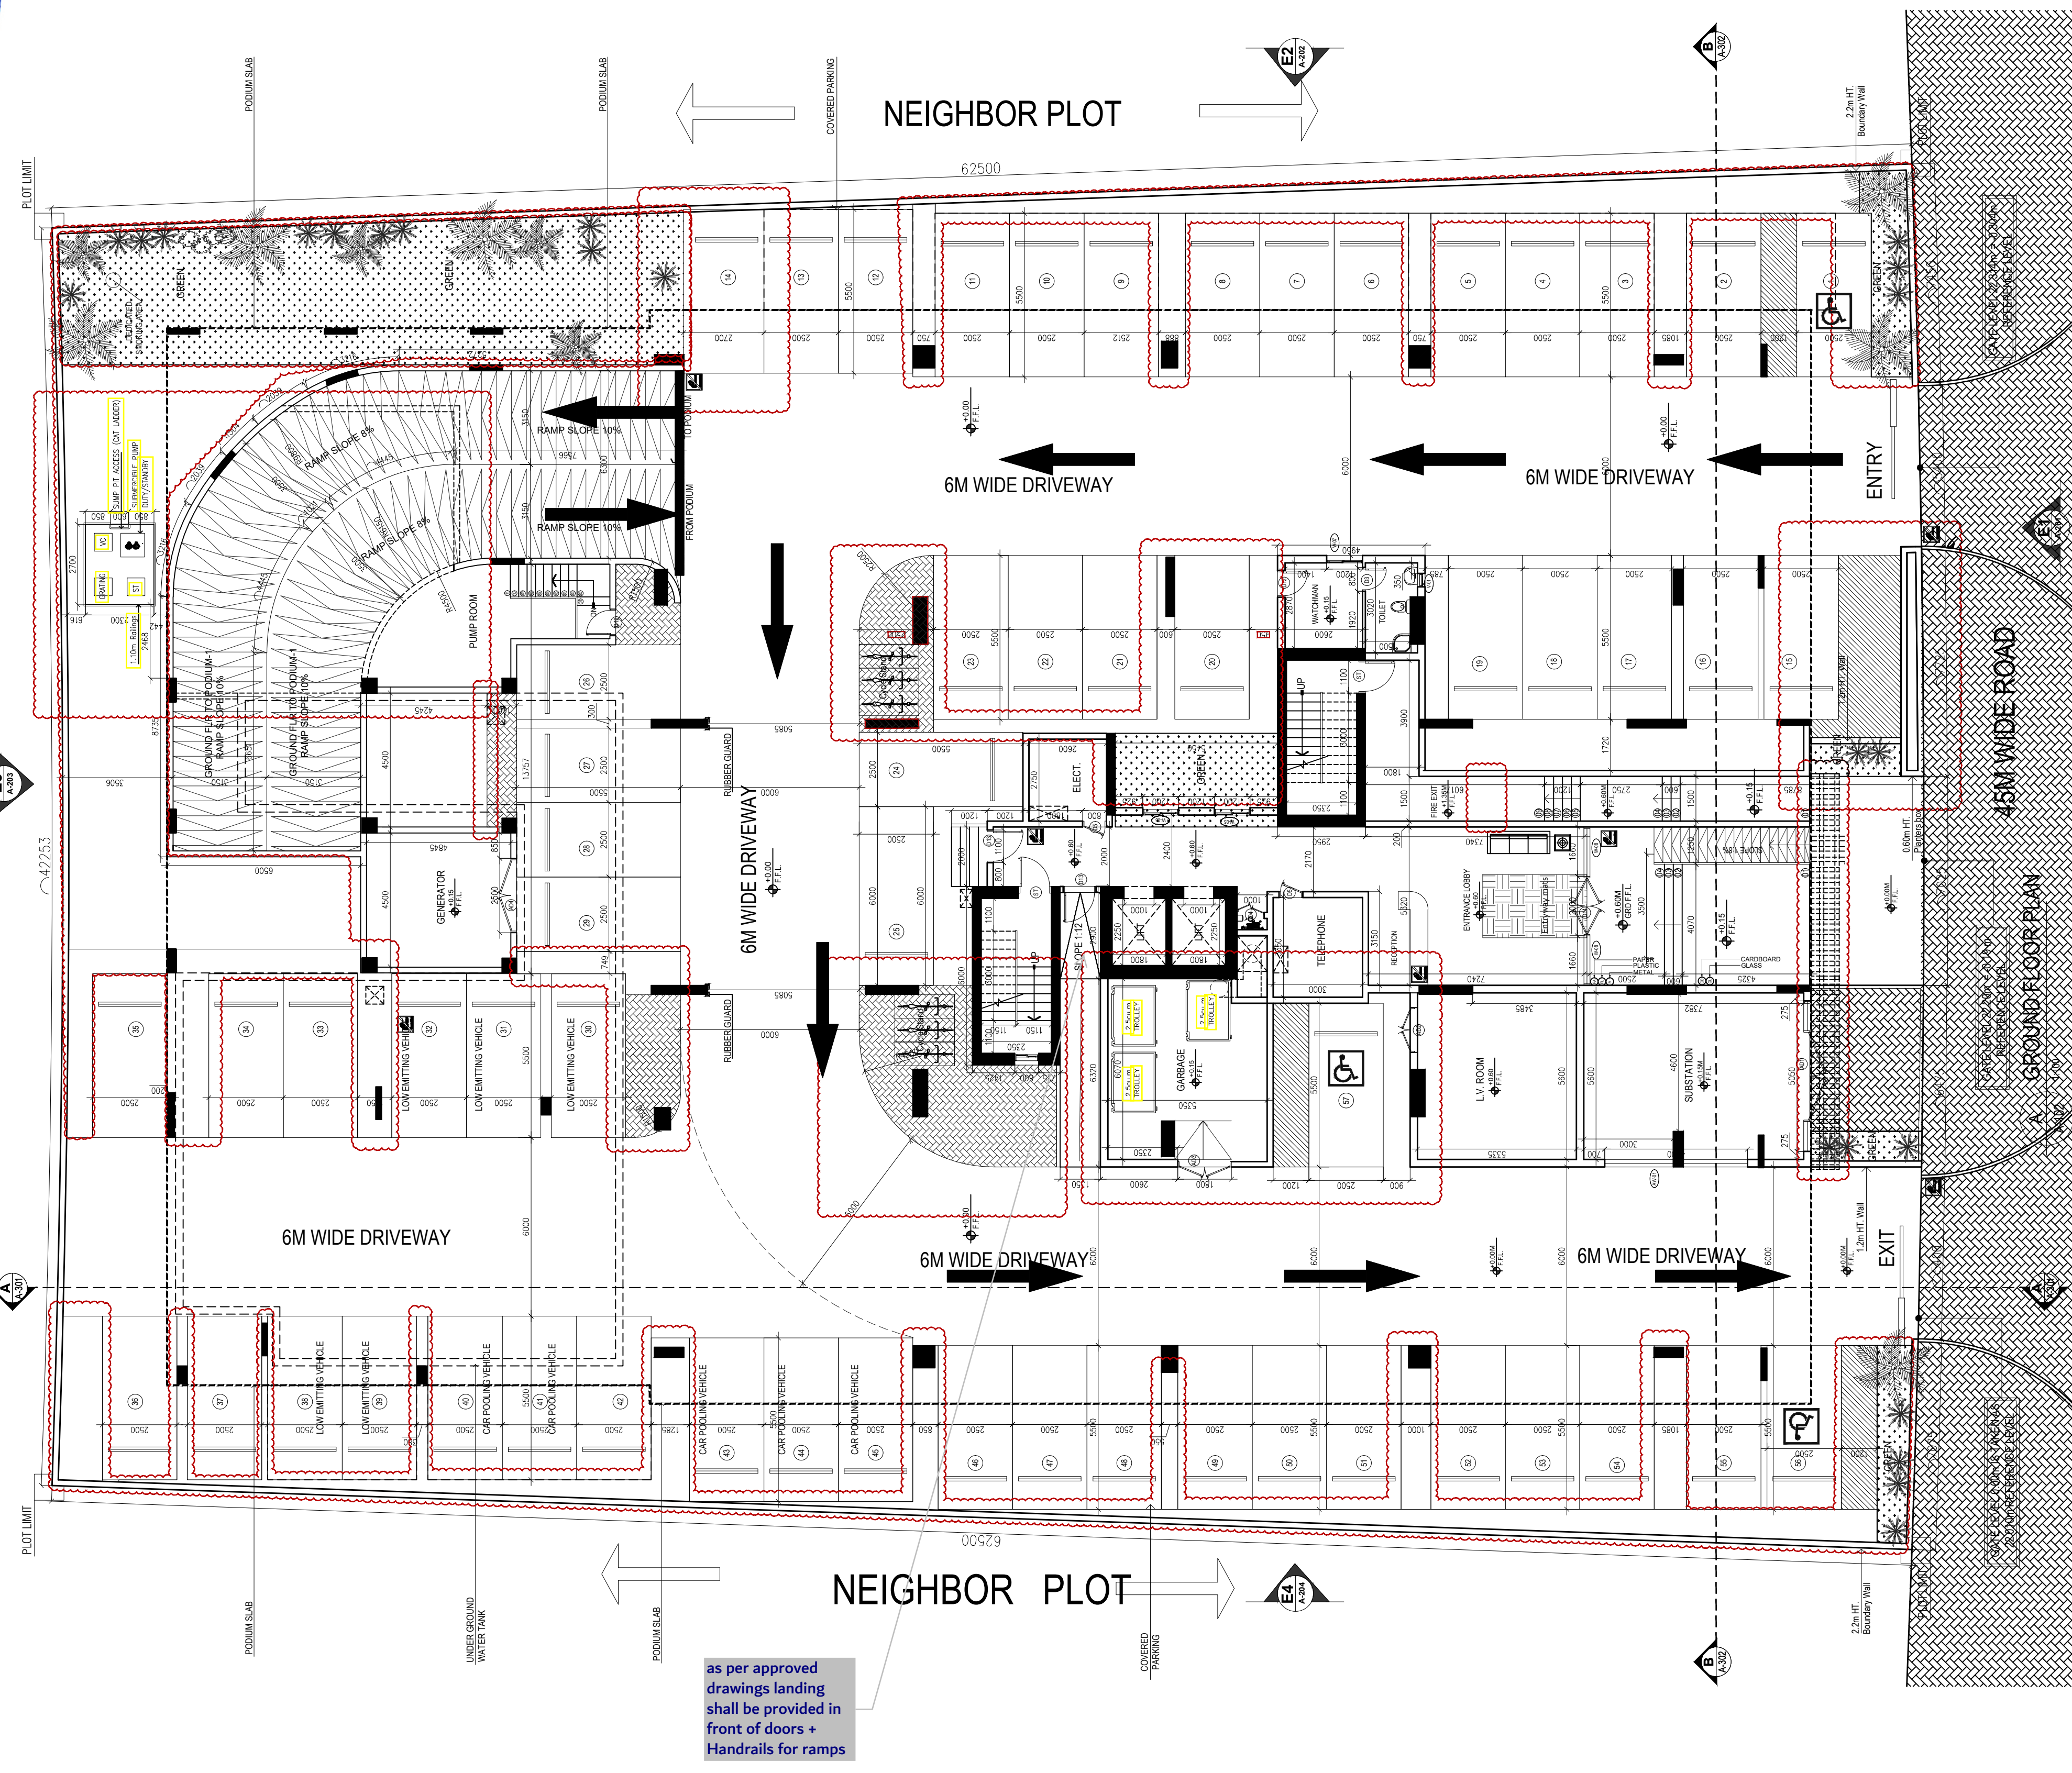

as per approved drawings landing shall be provided in front of doors + Handrails for ramps

NO OF PARKING SLOTS -56.00

AS BUILT

- GENERAL NOTES
1. THIS DRAWING IS THE PROPERTY OF :
na architects engineering consultancy
P.O.Box 237347, DUBAI.
IT IS FORBIDDEN TO PRODUCE ITS CONTENTS IN ANY FORM, EXCEPT FOR THE INTENDED PURPOSE.
 2. THIS DRAWING IS NOT TO BE SCALED. THE STATED DIMENSIONS ONLY ARE TO BE CONSIDERED.
 3. THE DISCREPANCIES ARE TO BE BROUGHT TO THE ATTENTION AND RESOLVED BY NA ARCHITECTS ENGINEERING CONSULTANCY BEFORE COMMENCEMENT OF ANY WORK.
 4. ALWAYS FOLLOWED WRITTEN DIMENSION.

LEGEND

- KEY PLAN
- NO SMOKING
 - BIN FOR PAPER
 - BIN FOR PLASTIC
 - BIN FOR METAL
 - BIN FOR CARDBOARD
 - BIN FOR GLASS

AS BUILT

CONTRACTORS REPRESENTATIVES	DATE	INITIALS
CM / PROJECT ENGINEER		
ARCHITECT		
STRUCTURAL ENGINEER		
SUBCONTRACTORS REPRESENTATIVES	DATE	INITIALS
MEP. COORDINATOR		
MECHANICAL ENGINEER		
ELECTRICAL ENGINEER		

PROJECT:	RESIDENTIAL BUILDING G+1P+7+ROOF
REVIEW STATUS	☐ A ☐ B ☐ C ☐ D
DATE REVIEWED	
REVIEWED BY	
PREVIOUS DTF NO.MC/P10/DTF/020-01	DATE:

Rev	Date	Description	Drawn	Checked
AB	05/11/2019	AS BUILT DRAWING SUBMISSION	RCF	Engr. Hazem
AB	02/11/2019	AS BUILT DRAWING SUBMISSION	RCF	Engr. Hazem

CLIENT :
MR. MASOOD ABDULLA MOHD
ABDULAZIZ AL ZAROONI

LOCATION	PLOT No.
IC- PHASE 3	IC3-H-40

PRINCIPAL CONSULTANT:

NA ARCHITECTS ENGINEERING CONSULTANCY
na architects engineering consultancy
P.O.Box 237347, DUBAI.
OFFICE 2801 THE EXCHANGE TOWER
BUSINESS BAY - DUBAI - U.A.E
TEL: 04-2777820 P.O.Box: 237347
WWW.NAARCHITECTS.COM

MAIN CONTRACTOR :


MC ALMABNA CONTRACTING COMPANY
DUBAI, U.A.E.
TEL: 04-2666699
FAX: 04-2666699
P.O.Box: 233146

SUB CONTRACTOR :

MC ALMABNA CONTRACTING COMPANY
DUBAI, U.A.E.
TEL: 04-2666699
FAX: 04-2666699
P.O.Box: 233146

DRAWING TITLE:
GROUND FLOOR PLAN

DRAWN BY: RCF	JOB NO: P-10	DATE: 05.11.2019
CHECKED BY: Engr. Hazem	SCALE: 1:100	SHEET SIZE: A1
PROJECT NO: NA/IC/B103 NA/IC/B103/15	SHOP DRAWING NO:	REV: AB

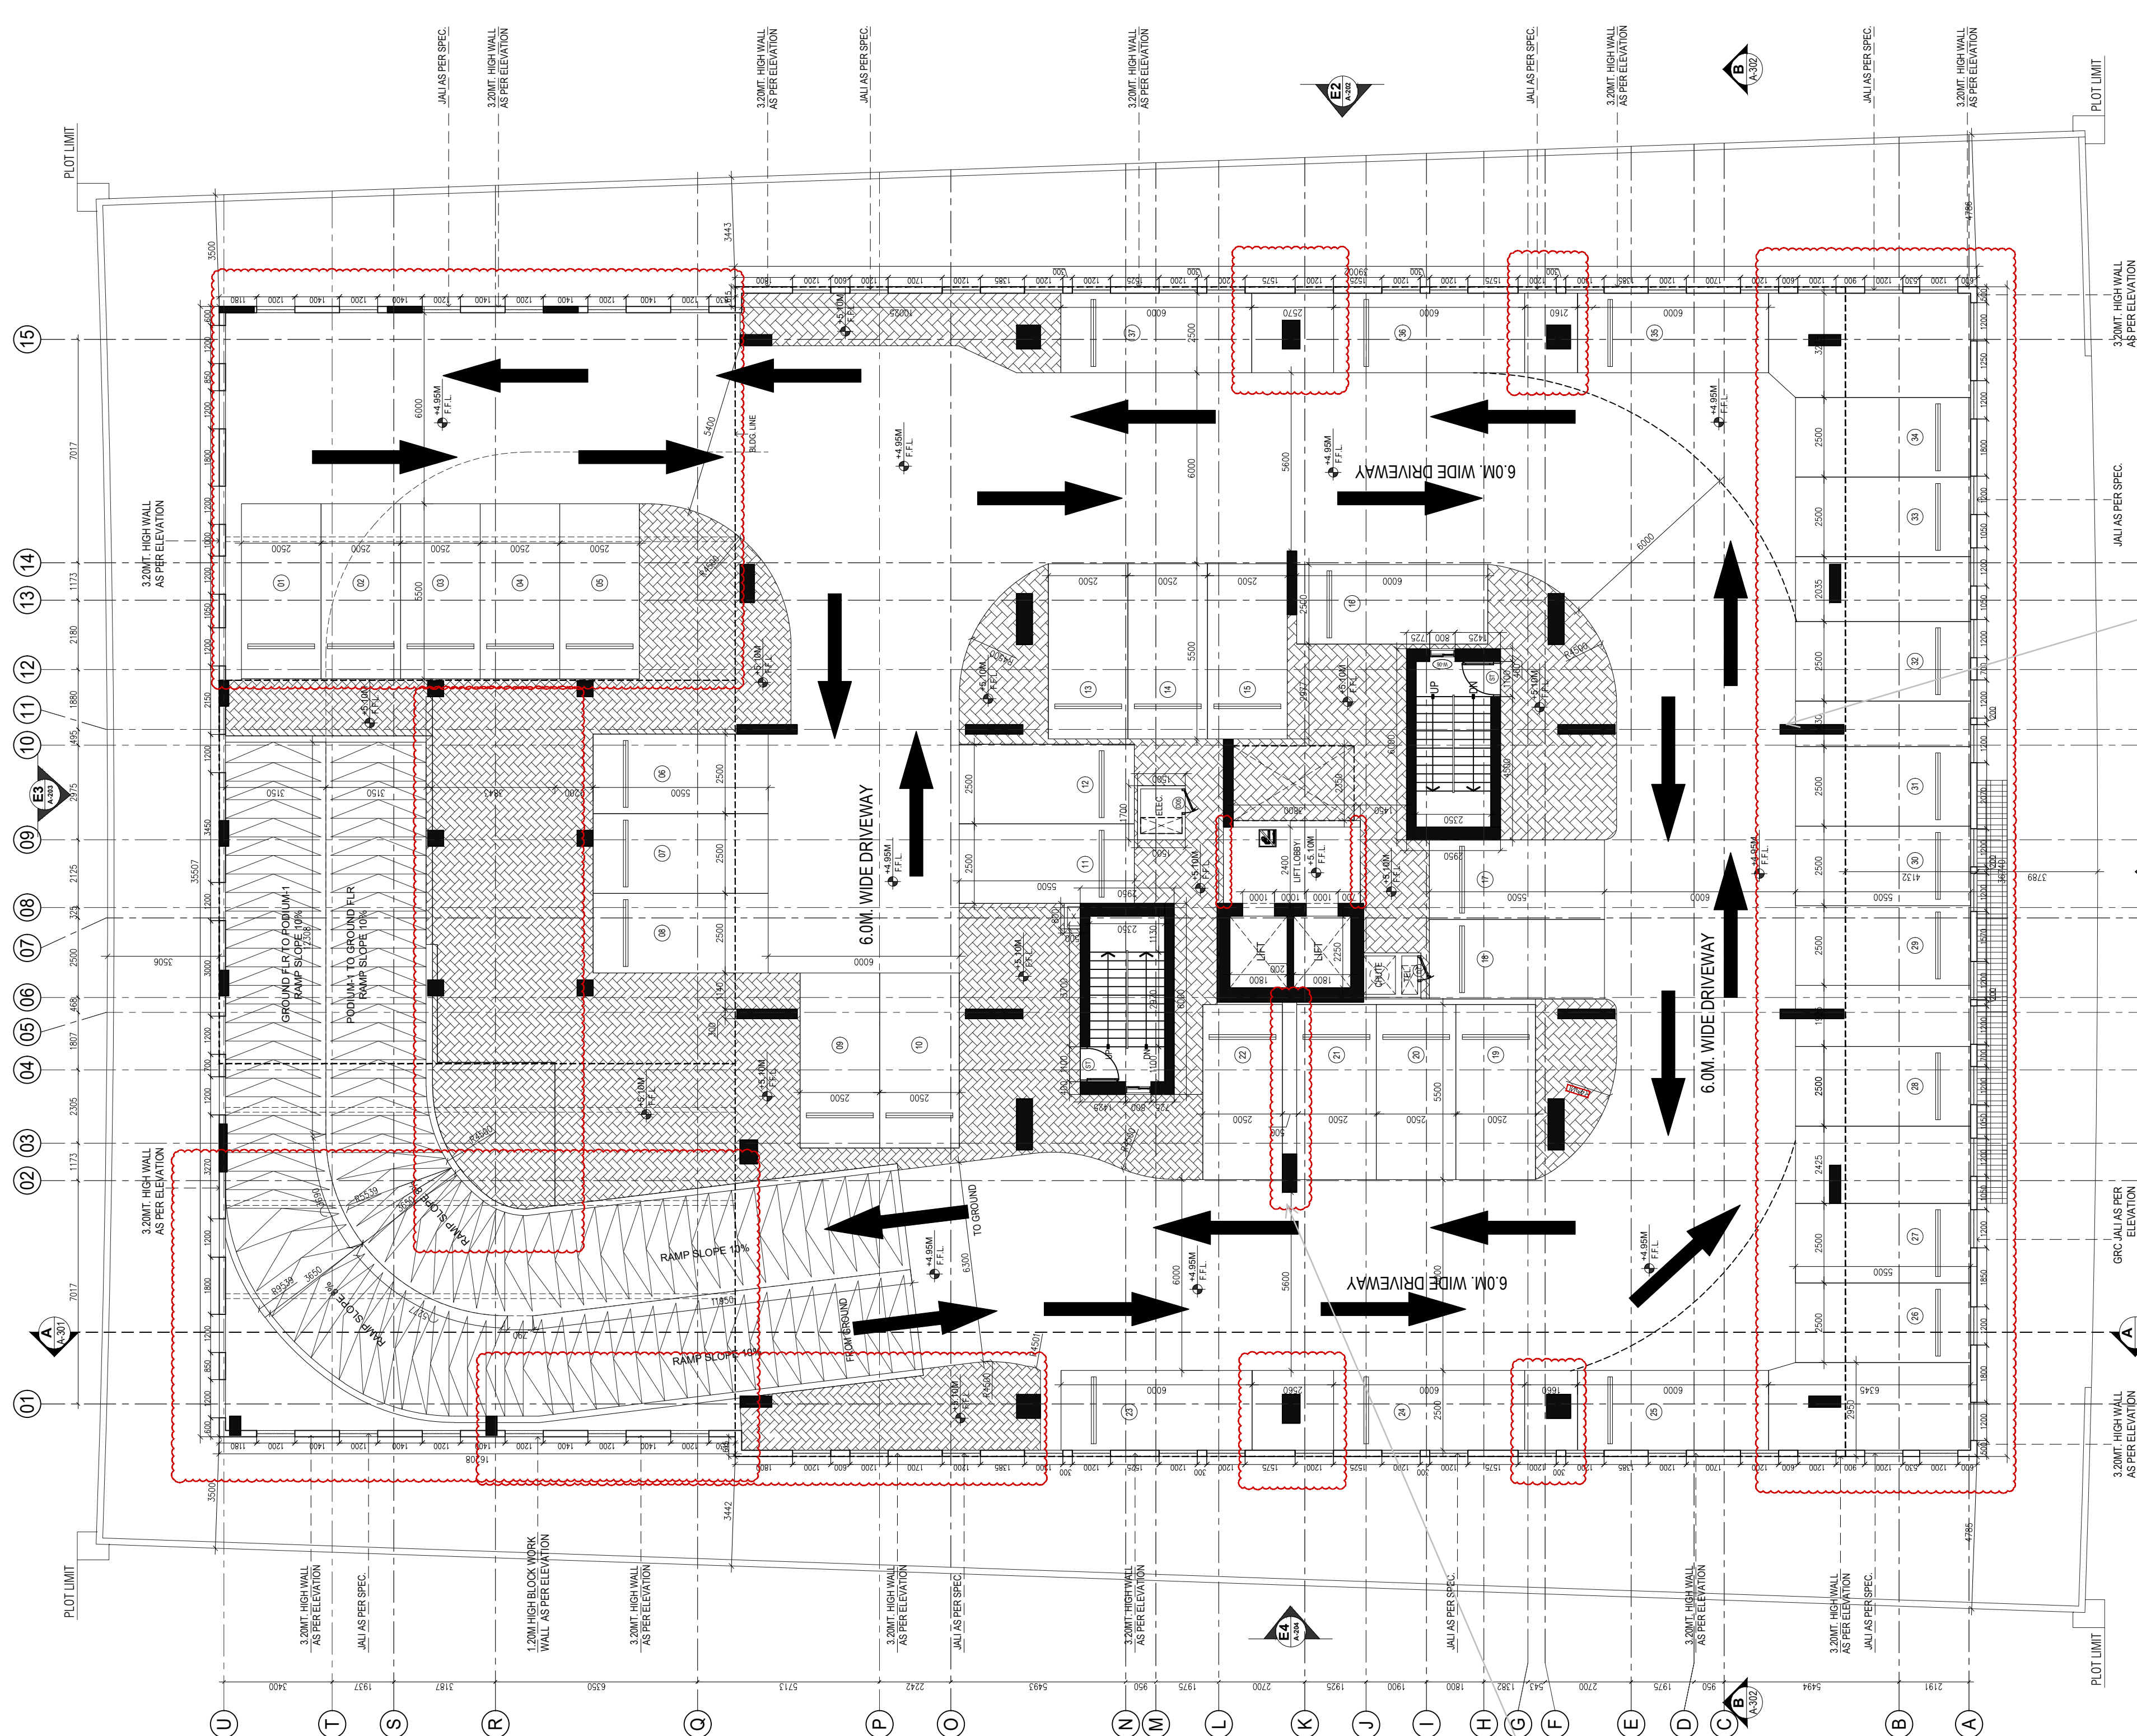

PODIUM FLOOR PLAN
A-103
1:100

GENERAL NOTES

- THIS DRAWING IS THE PROPERTY OF :
na architects engineering consultancy
P.O.Box 237347, DUBAI.
IT IS FORBIDDEN TO PRODUCE ITS CONTENTS IN ANY FORM, EXCEPT FOR THE INTENDED PURPOSE.
- THIS DRAWING IS NOT TO BE SCALED. THE STATED DIMENSIONS ONLY ARE TO BE CONSIDERED.
- THE DISCREPANCIES ARE TO BE BROUGHT TO THE ATTENTION AND RESOLVED BY NA ARCHITECTS ENGINEERING CONSULTANCY BEFORE COMMENCEMENT OF ANY WORK.
- ALWAYS FOLLOWED WRITTEN DIMENSION.

LEGEND

— NO SMOKING

KEY PLAN

AS BUILT

CONTRACTORS REPRESENTATIVES	DATE	INITIALS
CM / PROJECT ENGINEER		
ARCHITECT		
STRUCTURAL ENGINEER		

SUBCONTRACTORS REPRESENTATIVES	DATE	INITIALS
MEP. COORDINATOR		
MECHANICAL ENGINEER		
ELECTRICAL ENGINEER		

PROJECT:

**RESIDENTIAL BUILDING
G+1P+7+ROOF**

REVIEW STATUS	☐ A ☐ B ☐ C ☐ D
DATE REVIEWED	
REVIEWED BY	
DATE:	

Rev	Date	Description	Drawn	Checked
AB	05/11/2019	AS BUILT DRAWING SUBMISSION	RCF	Engr. Hazem
AB	02/11/2019	AS BUILT DRAWING SUBMISSION	RCF	Engr. Hazem

CLIENT:

**MR. MASOOD ABDULLA MOHD
ABDULAZIZ AL ZAROONI**

LOCATION	PLOT No.
IC- PHASE 3	IC3-H-40

PRINCIPAL CONSULTANT:

NA ان إيه أر كيجنس للاستشارات الهندسية
NA ARCHITECTS ENGINEERING CONSULTANCY

OFFICE 2601 / THE EXCHANGE TOWER
BUSINESS BAY - DUBAI - U.A.E
TEL: 04-2777820 P.O.BOX: 237347
www.naarchitects.net

MAIN CONTRACTOR:

MC ALMABNA CONTRACTING COMPANY
Dubai - U.A.E
P.O.Box: 237347

SUB CONTRACTOR:


MC ALMABNA CONTRACTING COMPANY
Dubai - U.A.E
P.O.Box: 237347

DRAWING TITLE:

PODIUM FLOOR PLAN

DRAWN BY:	JOB NO:	DATE:
RCF	P-10	05.11.2019
CHECKED BY:	SCALE:	SHEET SIZE:
Engr. Hazem	1:100	A1
PROJECT NO:	SHOP DRAWING NO:	REV:
NA/IC/B103 NA/IC/B103/15		AB

AS BUILT

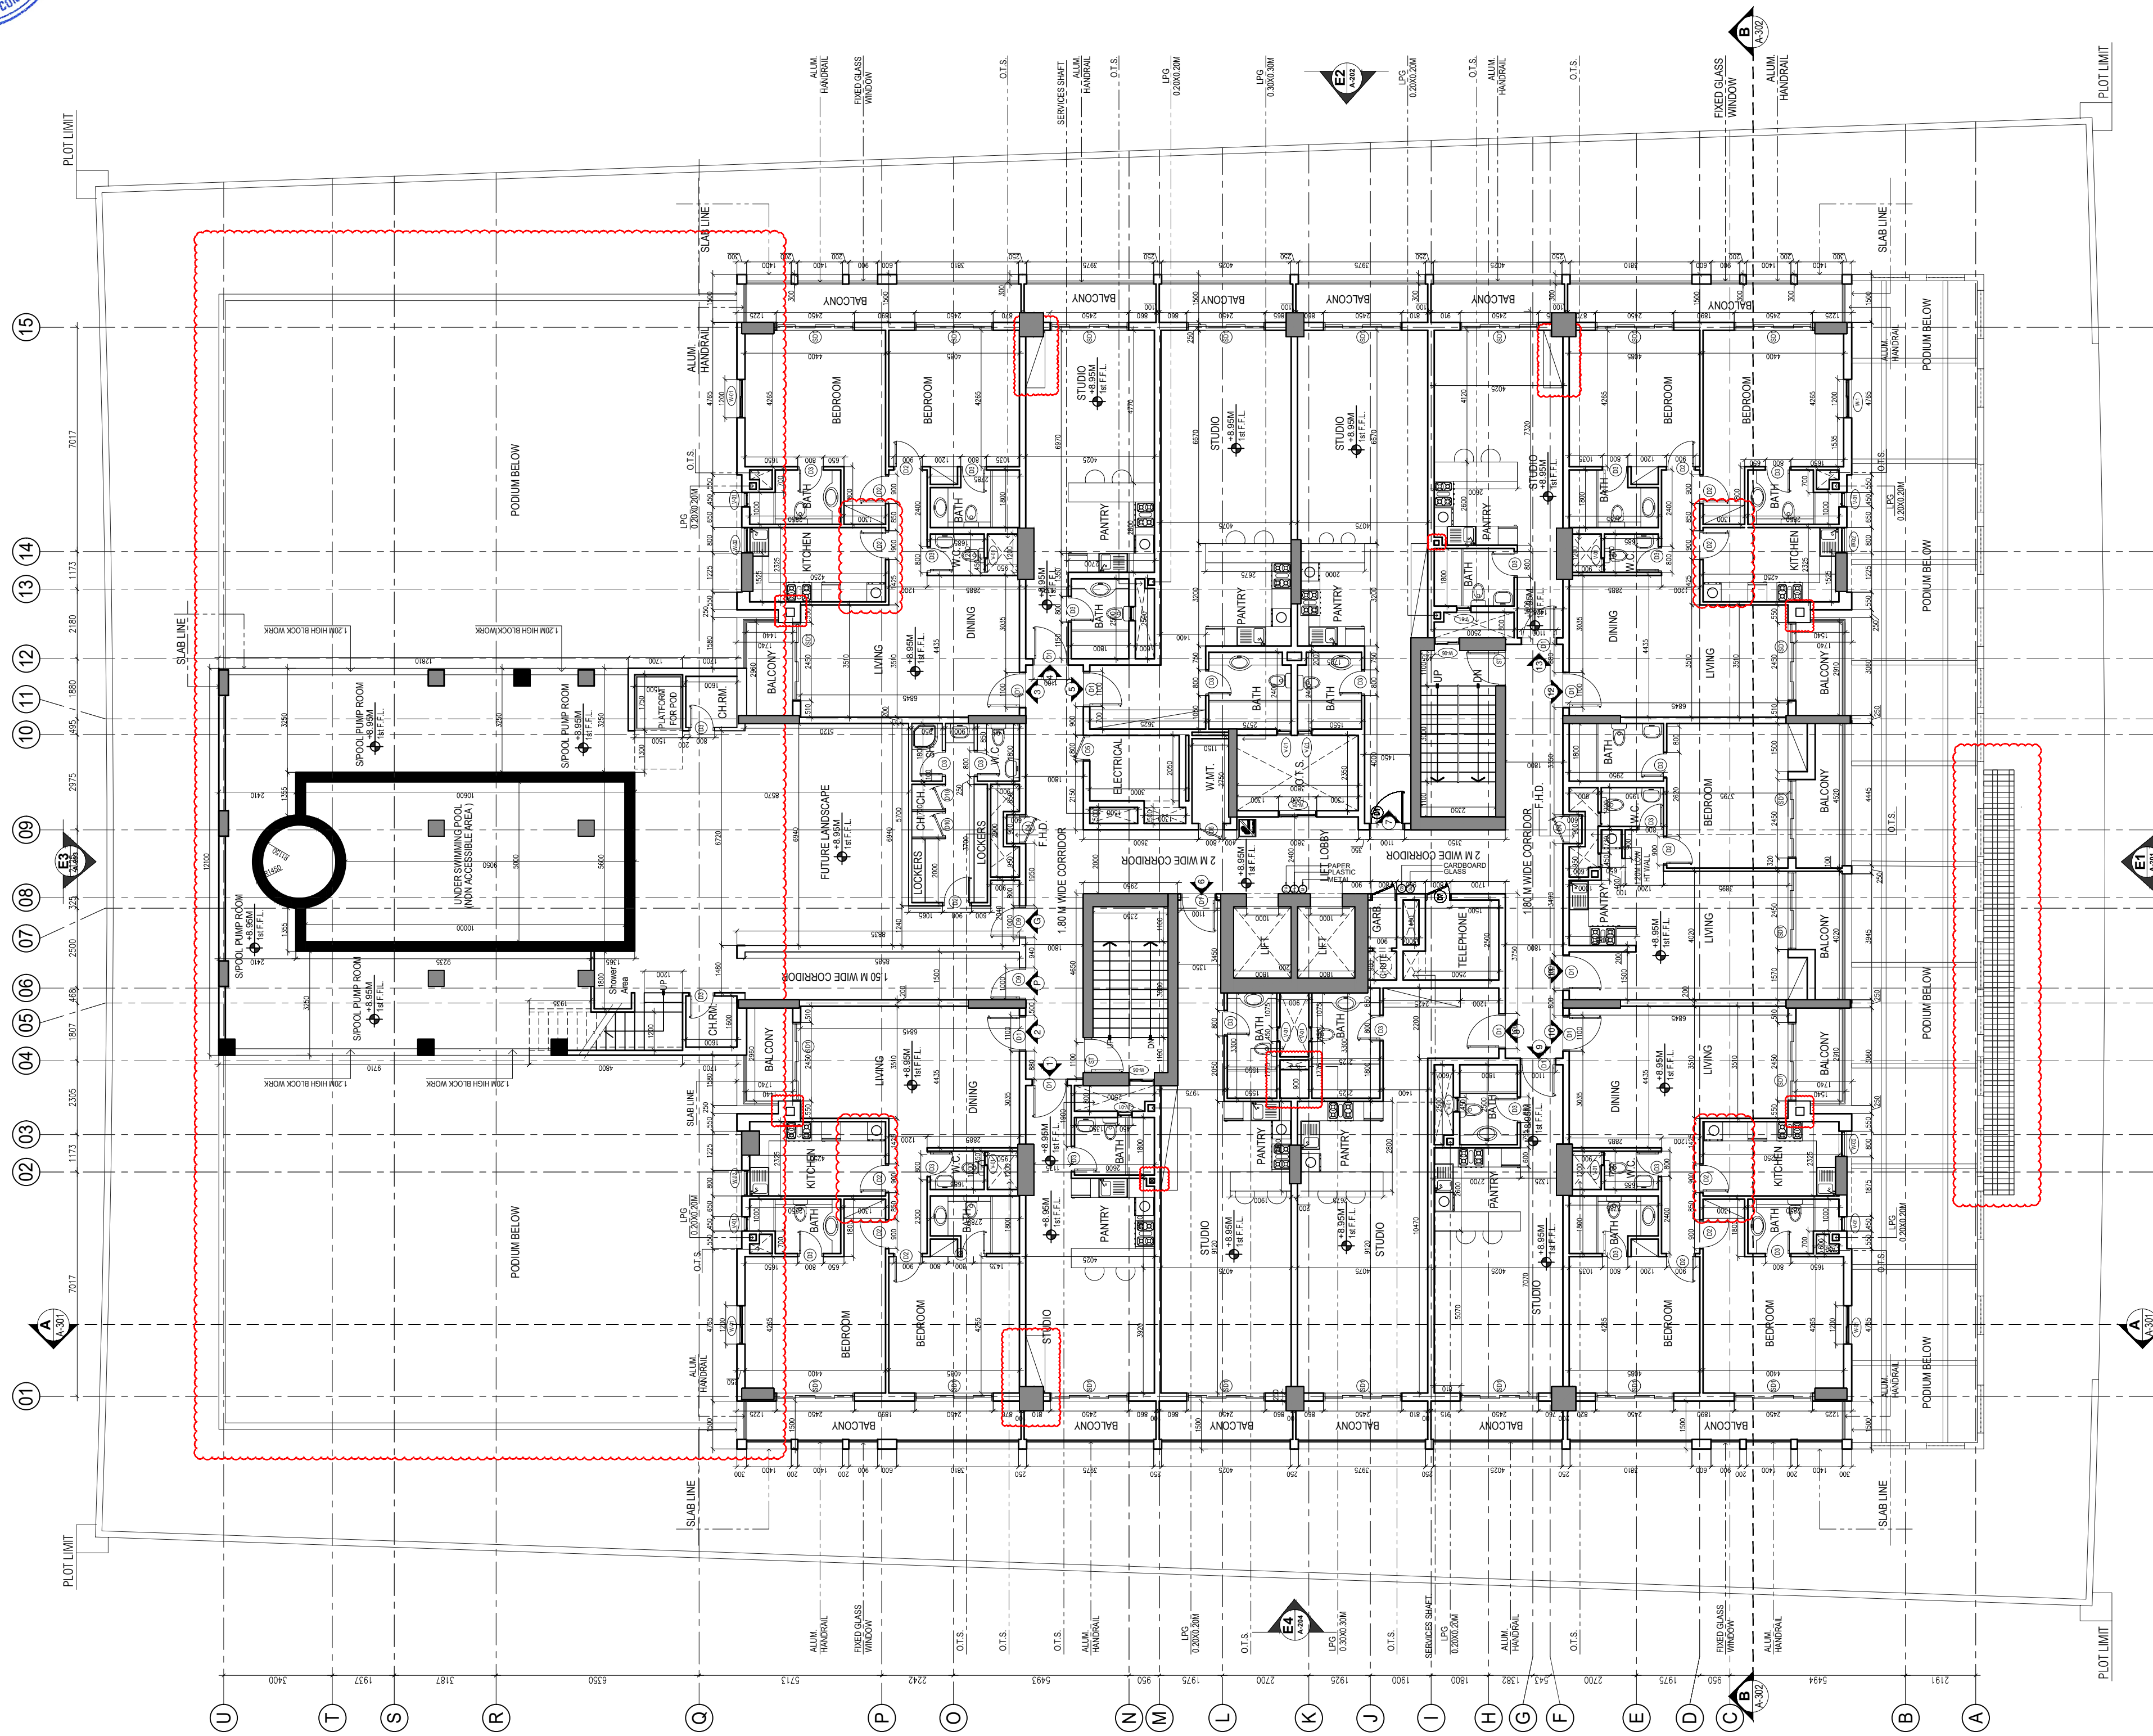

AS BUILT

- GENERAL NOTES
1. THIS DRAWING IS THE PROPERTY OF :
na architects engineering consultancy
P.O.Box 237347, DUBAI.
IT IS FORBIDDEN TO PRODUCE ITS CONTENTS IN ANY FORM, EXCEPT FOR THE INTENDED PURPOSE.
 2. THIS DRAWING IS NOT TO BE SCALED. THE STATED DIMENSIONS ONLY ARE TO BE CONSIDERED.
 3. THE DISCREPANCIES ARE TO BE BROUGHT TO THE ATTENTION AND RESOLVED BY NA ARCHITECTS ENGINEERING CONSULTANCY BEFORE COMMENCEMENT OF ANY WORK.
 4. ALWAYS FOLLOWED WRITTEN DIMENSION.

LEGEND

- KEY PLAN
- NO SMOKING
 - BIN FOR PAPER
 - BIN FOR PLASTIC
 - BIN FOR METAL
 - BIN FOR CARDBOARD
 - BIN FOR GLASS

AS BUILT

CONTRACTORS REPRESENTATIVES	DATE	INITIALS
CM / PROJECT ENGINEER		
ARCHITECT		
STRUCTURAL ENGINEER		
SUBCONTRACTORS REPRESENTATIVES	DATE	INITIALS
MEP. COORDINATOR		
MECHANICAL ENGINEER		
ELECTRICAL ENGINEER		

PROJECT:

RESIDENTIAL BUILDING
G+1P+7+ROOF

REVIEW STATUS

DATE REVIEWED

REVIEWED BY

DATE:

Rev	Date	Description	Drawn	Checked
AB	05/11/2019	AS BUILT DRAWING SUBMISSION	RCF	
AB	02/11/2019	AS BUILT DRAWING SUBMISSION	RCF	Engr. Hazem

CLIENT:

MR. MASOOD ABDULLA MOHD
ABDULAZIZ AL ZAROONI

LOCATION

IC- PHASE 3

PLOT No.

IC3-H-40

PRINCIPAL CONSULTANT:

NA ARCHITECTS ENGINEERING CONSULTANCY

OFFICE 2601 / THE EXCHANGE TOWER
BUSINESS BAY - DUBAI - U.A.E
TEL: 04-2777820 P.O.BOX: 237347
WWW.NAARCHITECTS.NET

MAIN CONTRACTOR:

MC

ALMABNA CONTRACTING COMPANY

SUB CONTRACTOR:


MC

ALMABNA CONTRACTING COMPANY

DRAWING TITLE:

1st FLOOR PLAN

DRAWN BY:	JOB NO:	DATE:
RCF	P-10	05.11.2019
CHECKED BY:	SCALE:	SHEET SIZE:
Engr. Hazem	1:100	A1
PROJECT NO:	SHOP DRAWING NO:	REV:
NA/IC/B103 NA/IC/B103/15		AB

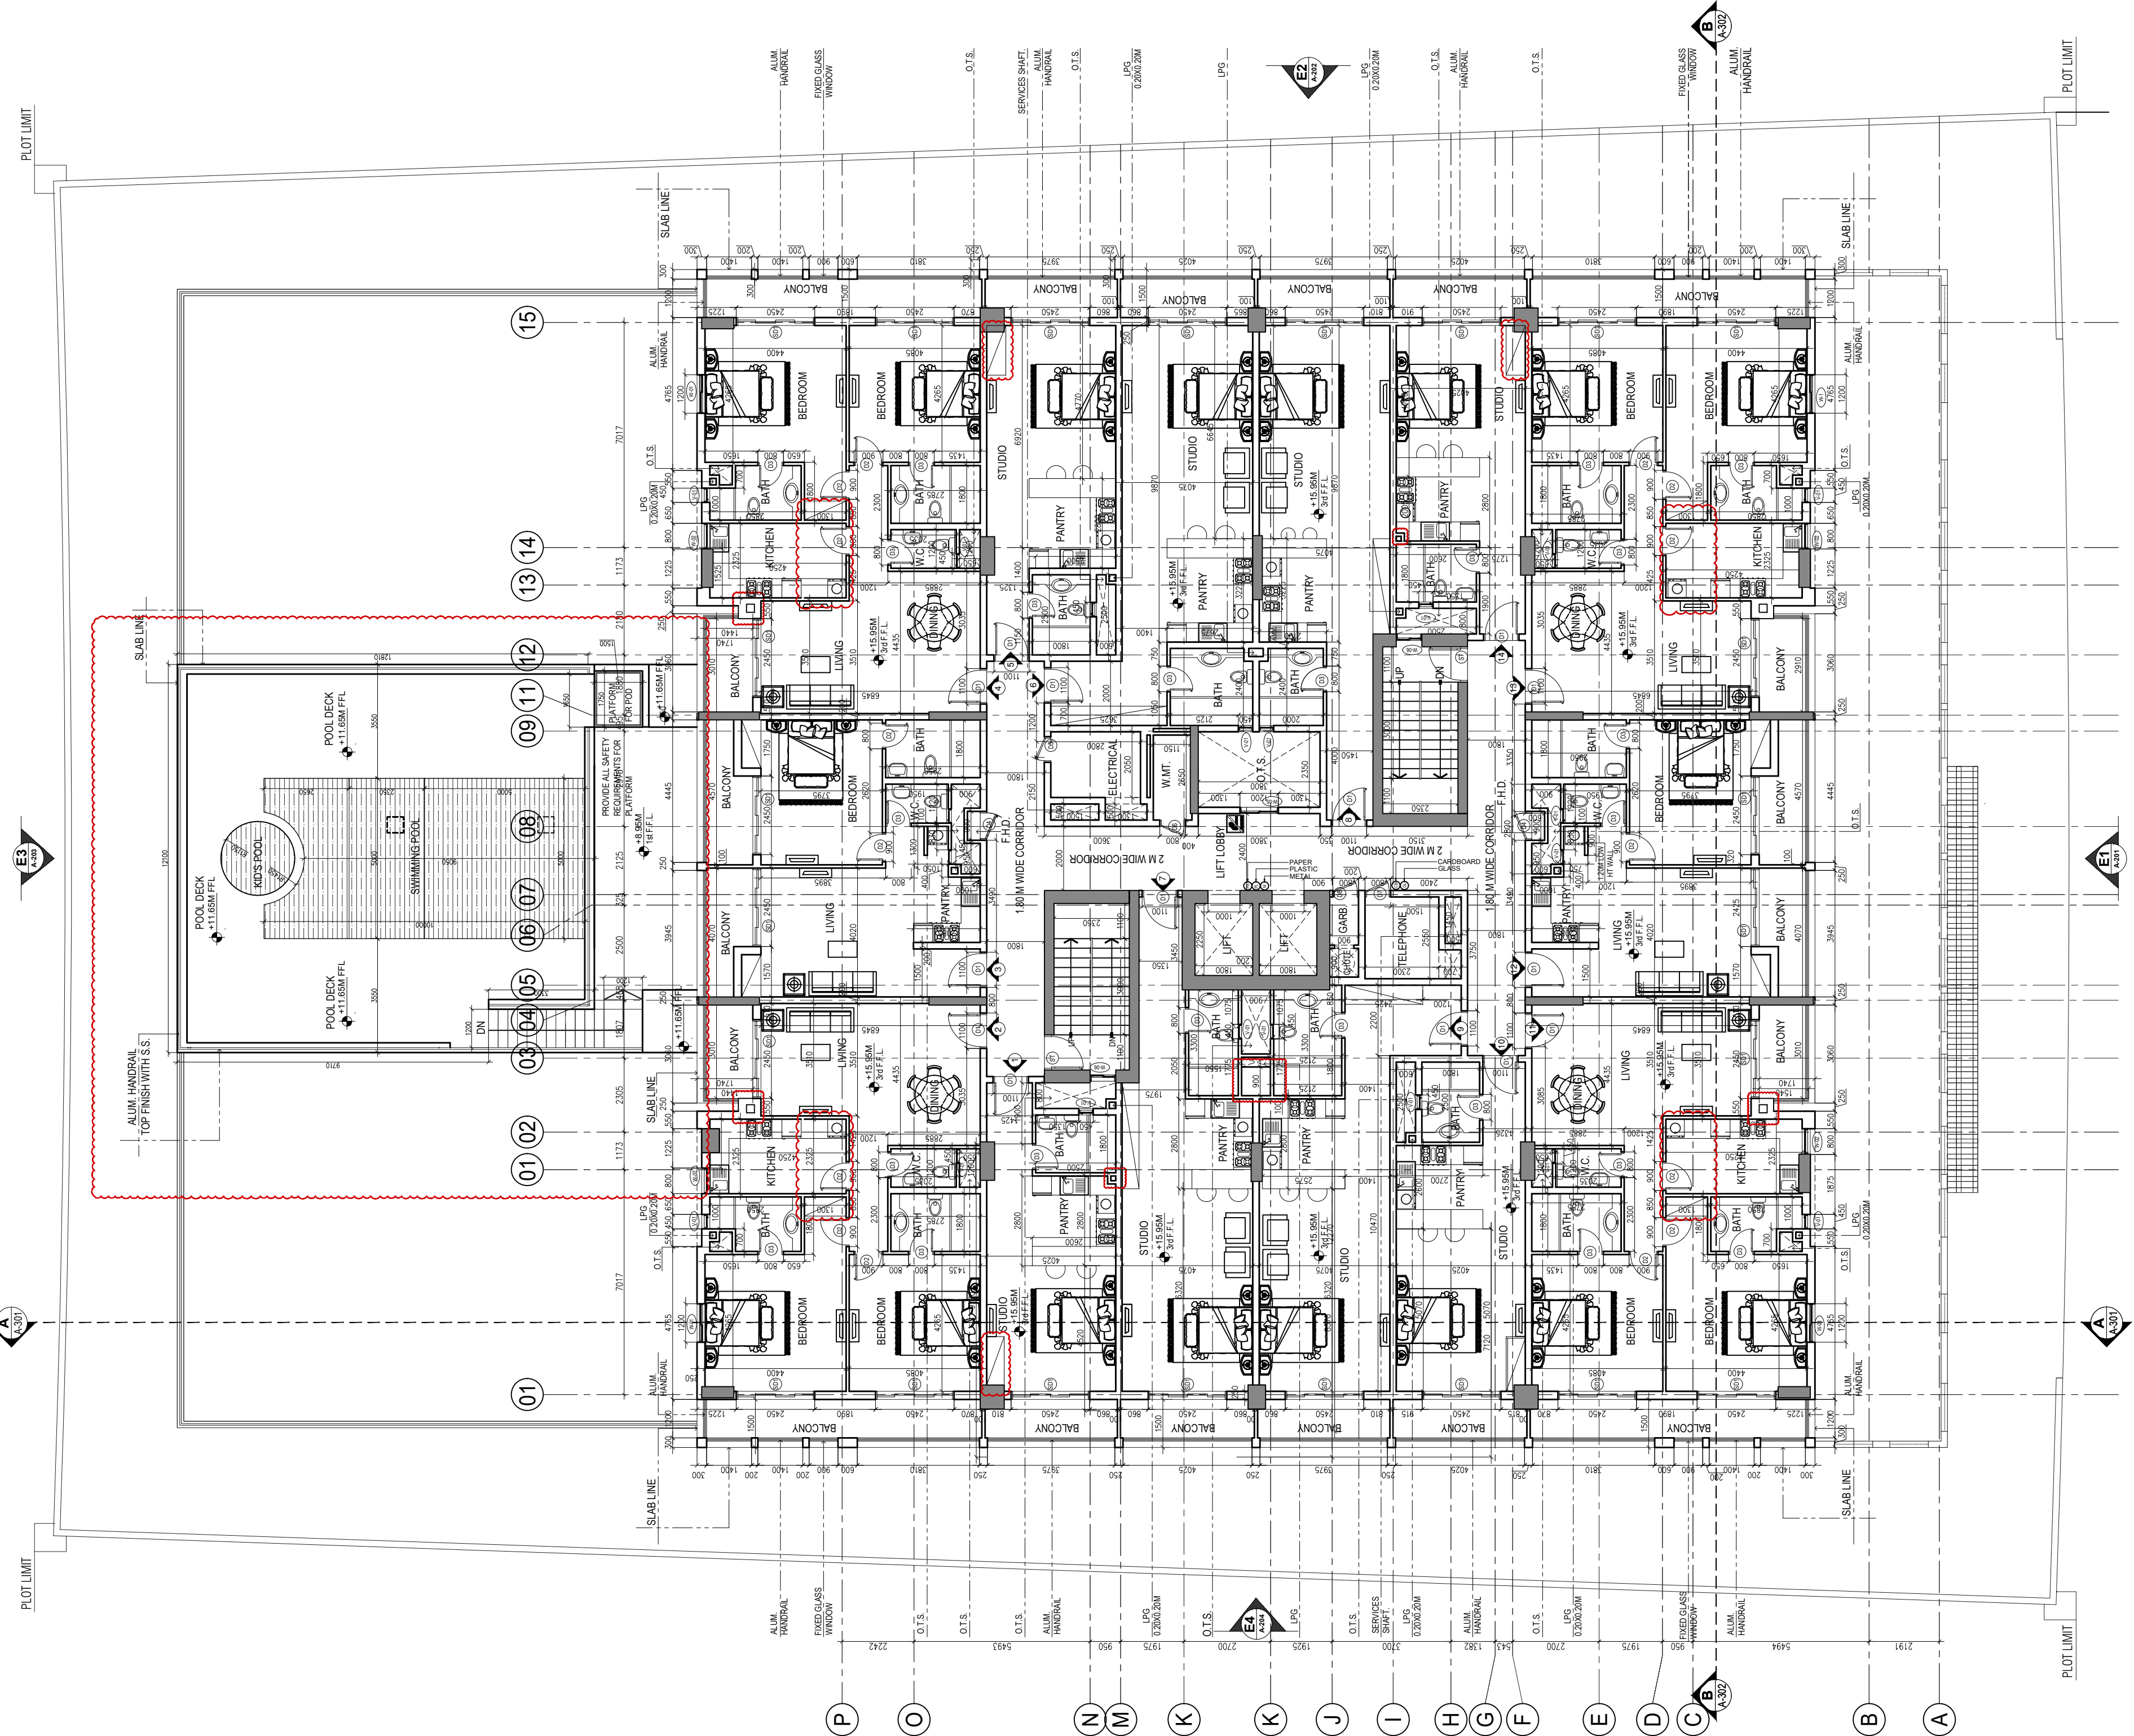

- GENERAL NOTES
1. THIS DRAWING IS THE PROPERTY OF :
na architects engineering consultancy
P.O.Box 237347, DUBAI.
IT IS FORBIDDEN TO PRODUCE ITS CONTENTS IN
ANY FORM, EXCEPT FOR THE INTENDED PURPOSE.
 2. THIS DRAWING IS NOT TO BE SCALED. THE STATED
DIMENSIONS ONLY ARE TO BE CONSIDERED.
 3. THE DISCREPANCIES ARE TO BE BROUGHT TO THE
ATTENTION AND RESOLVED BY NA ARCHITECTS
ENGINEERING CONSULTANCY BEFORE
COMMENCEMENT OF ANY WORK.
 4. ALWAYS FOLLOWED WRITTEN DIMENSION.

LEGEND

KEY PLAN

- NO SMOKING
- BIN FOR PAPER
- BIN FOR PLASTIC
- BIN FOR METAL
- BIN FOR CARDBOARD
- BIN FOR GLASS

AS BUILT

CONTRACTORS REPRESENTATIVES	DATE	INITIALS
CM / PROJECT ENGINEER		
ARCHITECT		
STRUCTURAL ENGINEER		
SUBCONTRACTORS REPRESENTATIVES	DATE	INITIALS
MEP. COORDINATOR		
MECHANICAL ENGINEER		
ELECTRICAL ENGINEER		

PROJECT:

RESIDENTIAL BUILDING
G+1P+7+ROOF

REVIEW STATUS

DATE REVIEWED

REVIEWED BY

DATE:

AB	05/11/2019	AS BUILT DRAWING SUBMISSION	RCF	Engr. Hazem
AB	02/11/2019	AS BUILT DRAWING SUBMISSION	RCF	Engr. Hazem
Rev	Date	Description	Drawn	Checked

CLIENT:

MR. MASOOD ABDULLA MOHD
ABDULAZIZ AL ZAROONI

LOCATION	PLOT No.
IC- PHASE 3	IC3-H-40

PRINCIPAL CONSULTANT:

NA ان ايه ار كيتس للاستشارات الهندسية
NA ARCHITECTS ENGINEERING CONSULTANCY

OFFICE 2601 / THE EXCHANGE TOWER
BUSINESS BAY - DUBAI - U.A.E
TEL: 04-2777820 P.O.BOX: 237347
www.naarchitects.net

MAIN CONTRACTOR:

MC ALMABNA CONTRACTING COMPANY

SUB CONTRACTOR:

MC ALMABNA CONTRACTING COMPANY

DRAWING TITLE:

2ND & 3RD FLOOR PLAN

DRAWN BY:	JOB NO:	DATE:
RCF	P-10	05.11.2019
CHECKED BY:	SCALE:	SHEET SIZE:
Engr. Hazem	1:100	A1
PROJECT NO:	SHOP DRAWING NO:	REV:
NA/IC/B103 NA/IC/B103/15		AB

AS BUILT



- GENERAL NOTES
- THIS DRAWING IS THE PROPERTY OF :
na architects engineering consultancy
P.O.Box 237347, Dubai.
IT IS FORBIDDEN TO PRODUCE ITS CONTENTS IN ANY FORM, EXCEPT FOR THE INTENDED PURPOSE.
 - THIS DRAWING IS NOT TO BE SCALED. THE STATED DIMENSIONS ONLY ARE TO BE CONSIDERED.
 - THE DISCREPANCIES ARE TO BE BROUGHT TO THE ATTENTION AND RESOLVED BY NA ARCHITECTS ENGINEERING CONSULTANCY BEFORE COMMENCEMENT OF ANY WORK.
 - ALWAYS FOLLOWED WRITTEN DIMENSION.

LEGEND

- KEY PLAN
- NO SMOKING
 - BIN FOR PAPER
 - BIN FOR PLASTIC
 - BIN FOR METAL
 - BIN FOR CARDBOARD
 - BIN FOR GLASS

AS BUILT

CONTRACTORS REPRESENTATIVES	DATE	INITIALS
CM / PROJECT ENGINEER		
ARCHITECT		
STRUCTURAL ENGINEER		
SUBCONTRACTORS REPRESENTATIVES	DATE	INITIALS
MEP. COORDINATOR		
MECHANICAL ENGINEER		
ELECTRICAL ENGINEER		

PROJECT:

RESIDENTIAL BUILDING
G+1P+7+ROOF

REVIEW STATUS: ☐ A ☐ B ☐ C ☐ D

DATE REVIEWED: _____

REVIEWED BY: _____

DATE: _____

Rev	Date	Description	Drawn	Checked
AB	02/11/2019	AS BUILT DRAWING SUBMISSION	RCF	Engr. Hazem

CLIENT:

MR. MASOOD ABDULLA MOHD
ABDULAZIZ AL ZAROONI

LOCATION: IC- PHASE 3

PLOT No. IC3-H-40

PRINCIPAL CONSULTANT:

NA ان ايه آر كيكتس للاستشارات الهندسية
NA ARCHITECTS ENGINEERING CONSULTANCY

OFFICE 2601 / THE EXCHANGE TOWER
BUSINESS BAY - DUBAI - U.A.E
TEL: 04-2777825 P.O.BOX: 237347
WWW.NAARCHITECTS.NET

MAIN CONTRACTOR:

MC ALMABNA CONTRACTING COMPANY

SUB CONTRACTOR:


MC ALMABNA CONTRACTING COMPANY

DRAWING TITLE:


4TH FLOOR PLAN

DRAWN BY: RCF	JOB NO: P-10	DATE: 02.11.2019
CHECKED BY: Engr. Hazem	SCALE: 1:100	SHEET SIZE: A1
PROJECT NO: NA/IC/B103	SHOP DRAWING NO:	REV: AB

AS BUILT

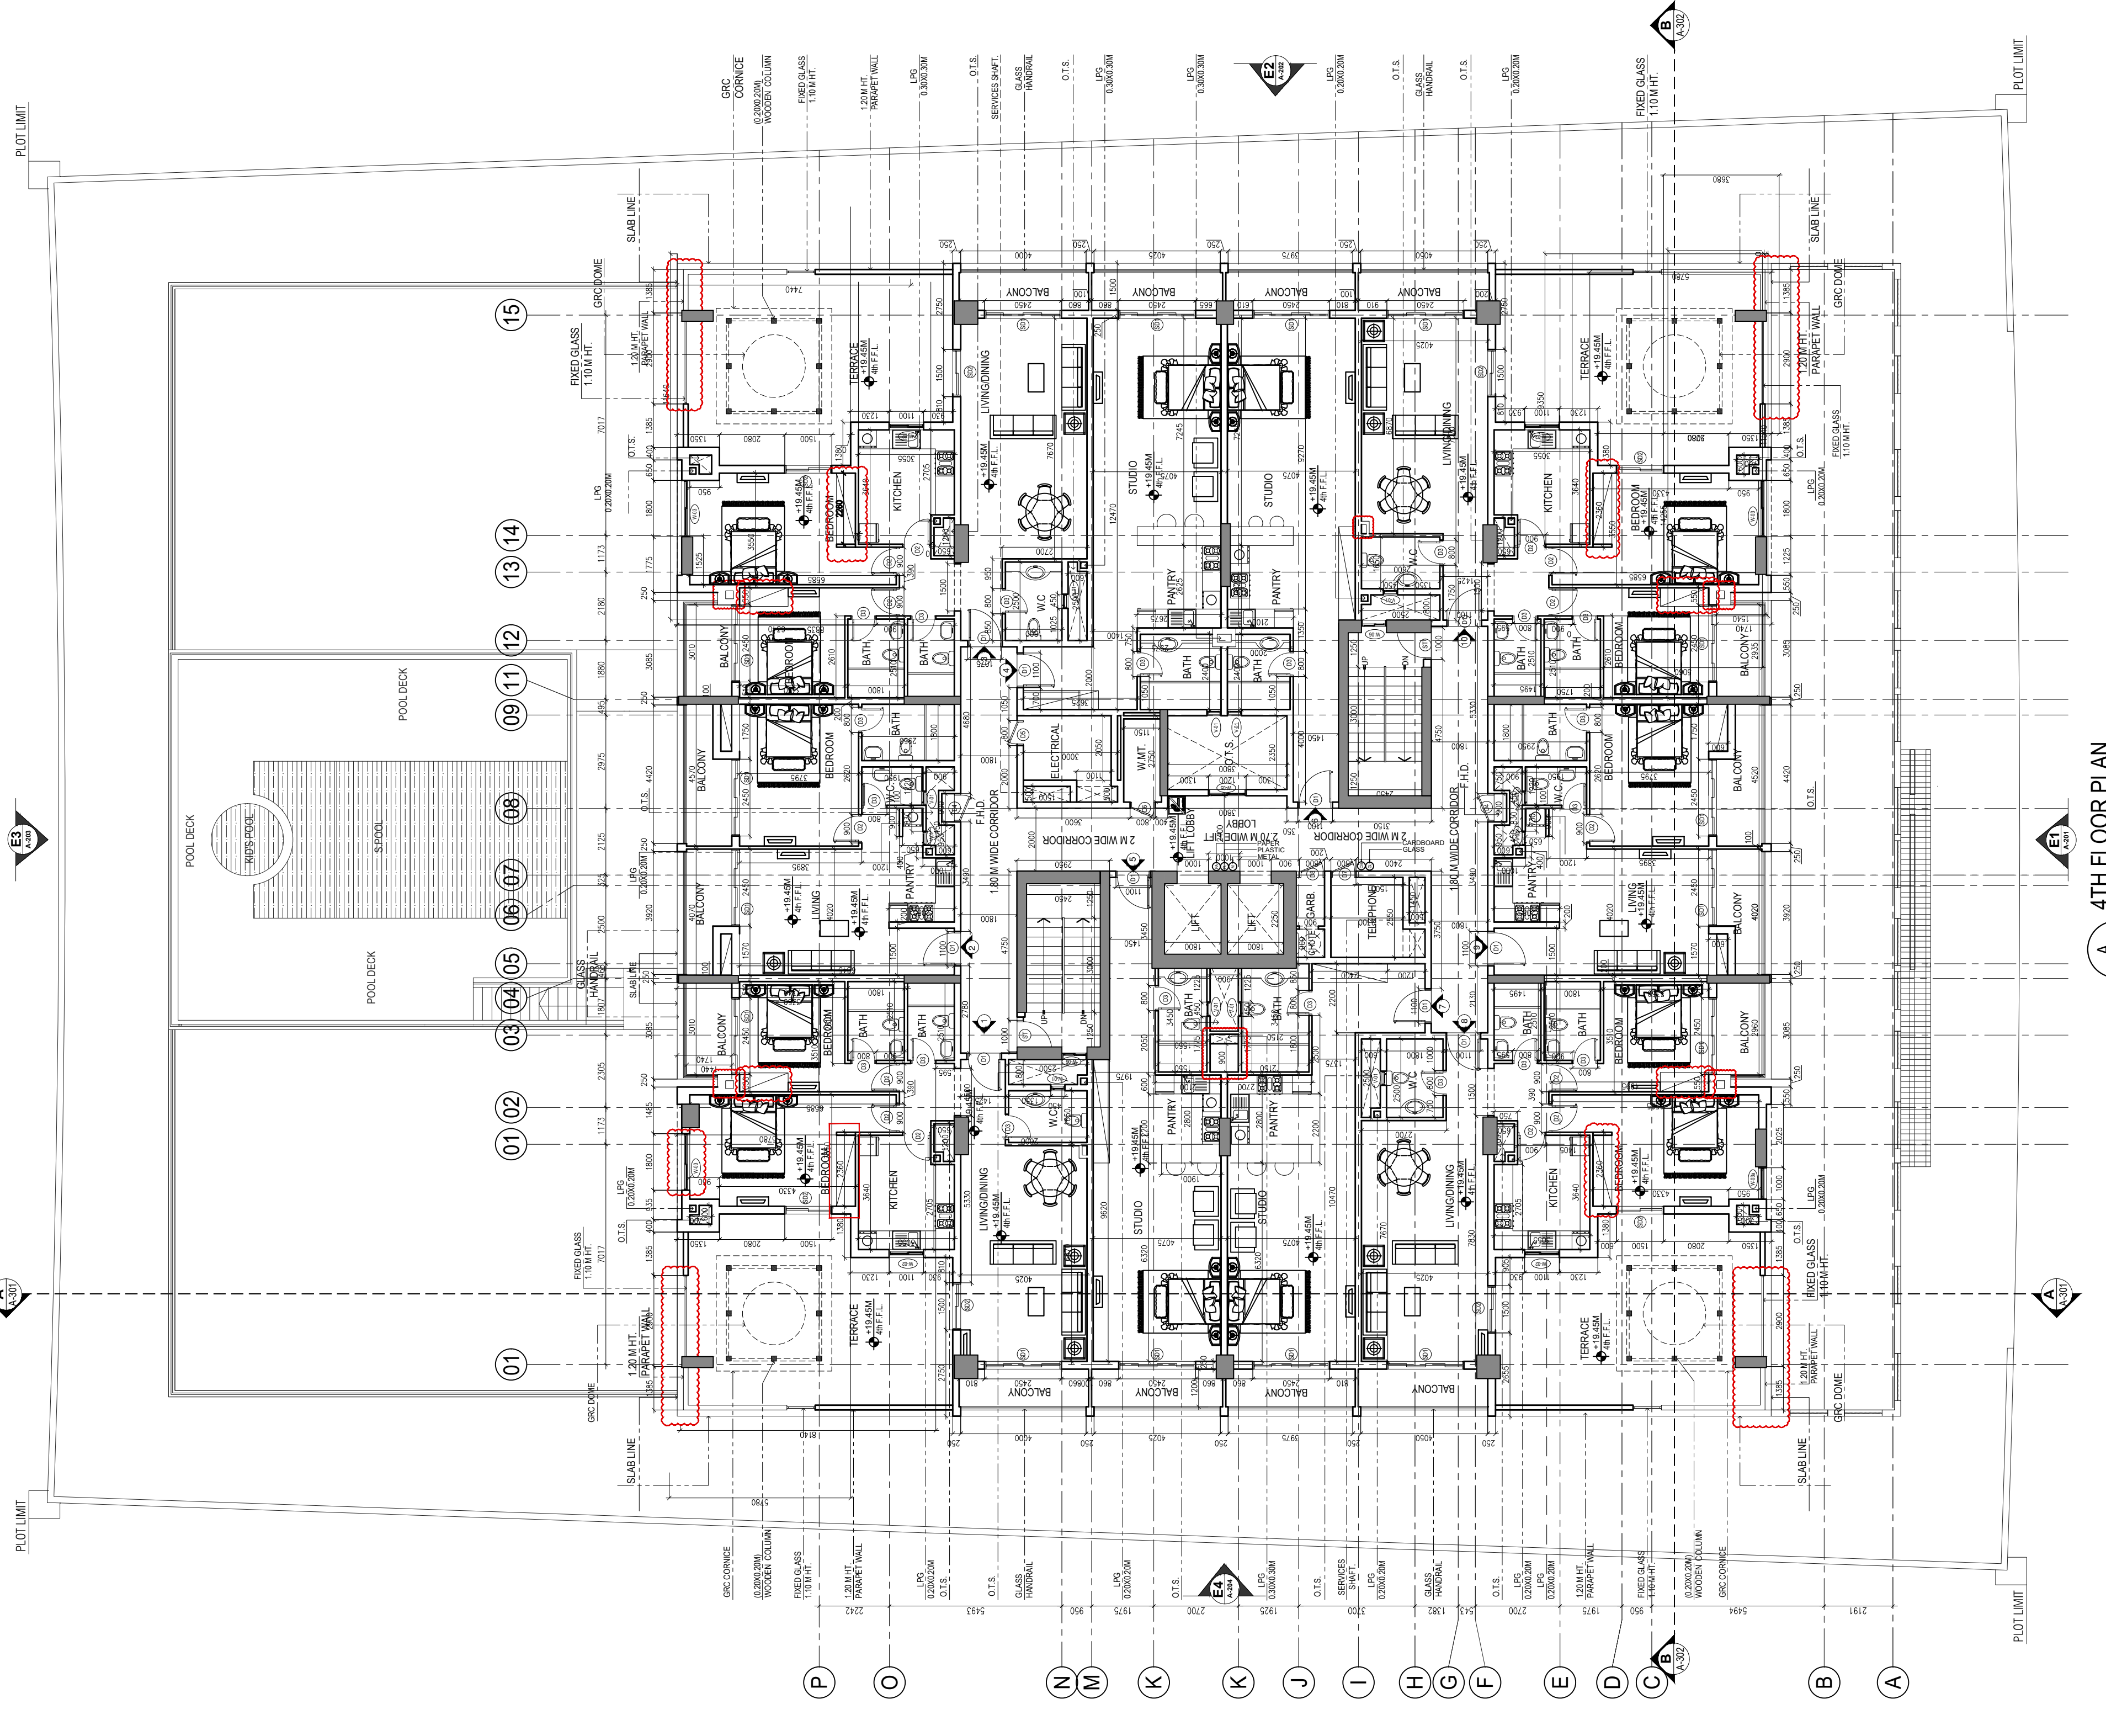

4TH FLOOR PLAN
A-105
1:100

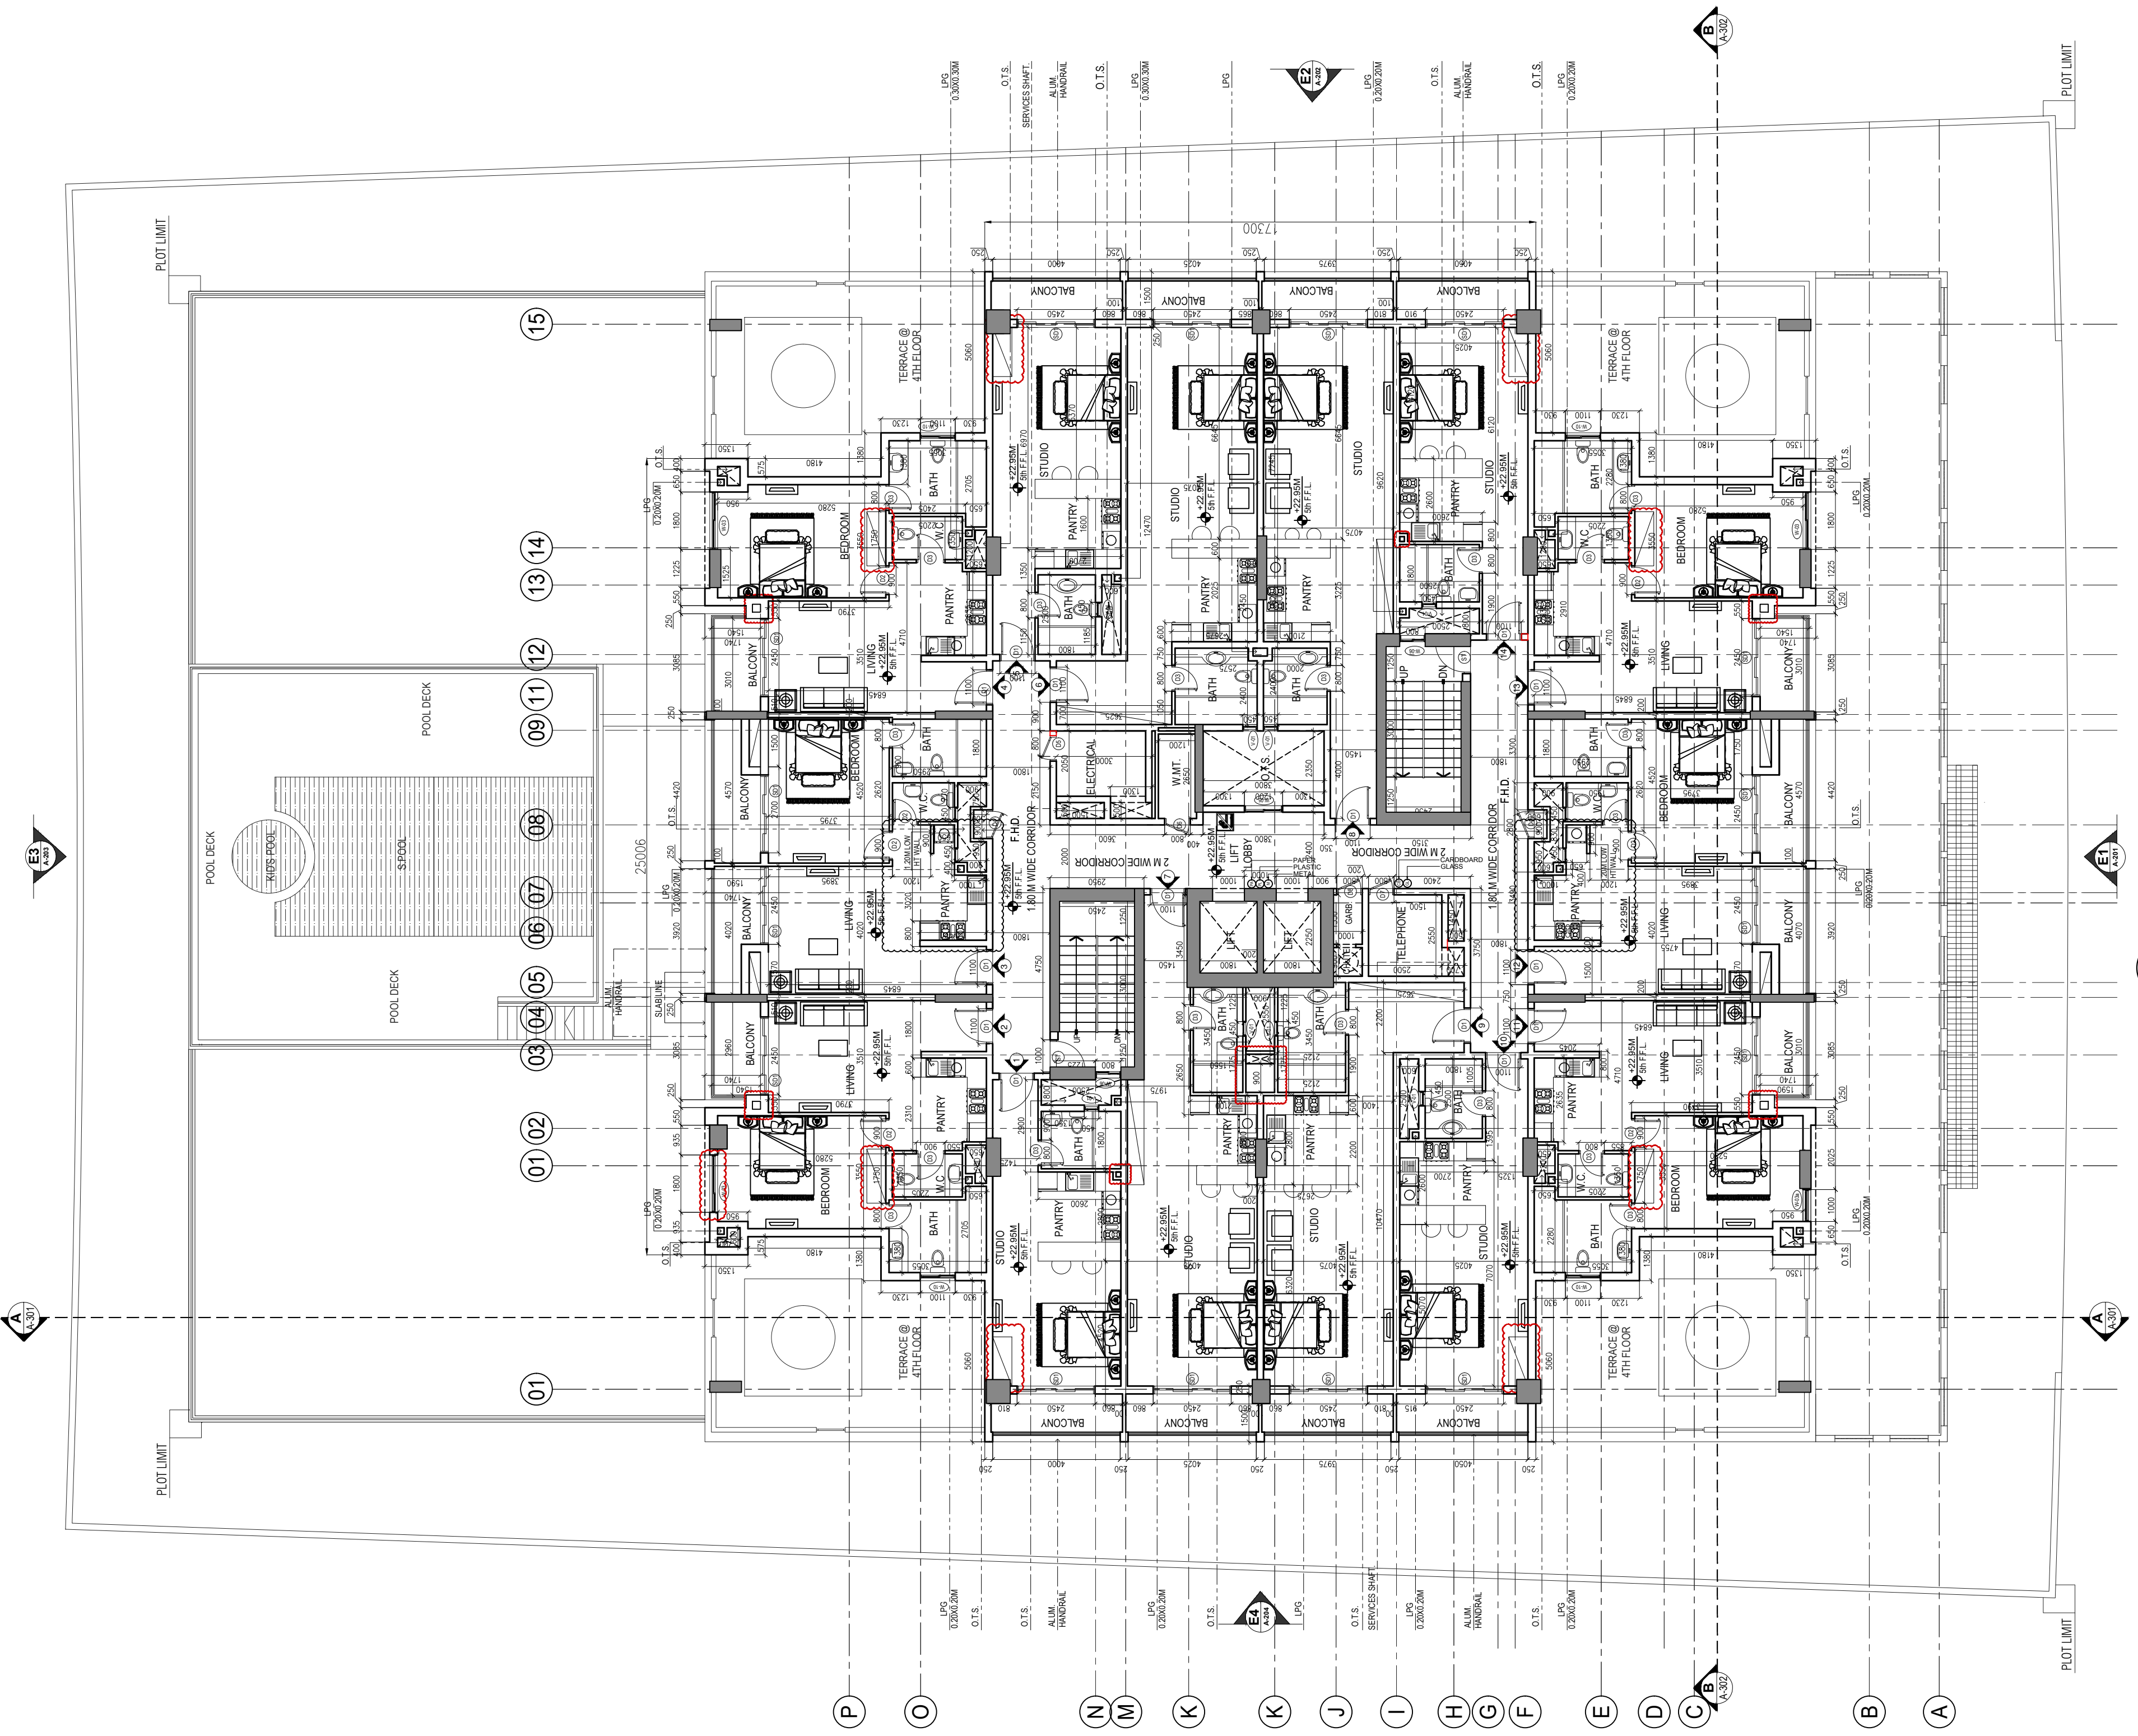

5TH FLOOR PLAN
A-107 1:100

- GENERAL NOTES
1. THIS DRAWING IS THE PROPERTY OF :
na architects engineering consultancy
P.O.Box 237347, DUBAI.
IT IS FORBIDDEN TO PRODUCE IT'S CONTENTS IN ANY FORM, EXCEPT FOR THE INTENDED PURPOSE.
 2. THIS DRAWING IS NOT TO BE SCALED. THE STATED DIMENSIONS ONLY ARE TO BE CONSIDERED.
 3. THE DISCREPANCIES ARE TO BE BROUGHT TO THE ATTENTION AND RESOLVED BY NA ARCHITECTS ENGINEERING CONSULTANCY BEFORE COMMENCEMENT OF ANY WORK.
 4. ALWAYS FOLLOWED WRITTEN DIMENSION.

LEGEND

- KEY PLAN
- NO SMOKING
 - BIN FOR PAPER
 - BIN FOR PLASTIC
 - BIN FOR METAL
 - BIN FOR CARDBOARD
 - BIN FOR GLASS

AS BUILT

CONTRACTORS REPRESENTATIVES	DATE	INITIALS
CM / PROJECT ENGINEER		
ARCHITECT		
STRUCTURAL ENGINEER		
SUBCONTRACTORS REPRESENTATIVES	DATE	INITIALS
MEP. COORDINATOR		
MECHANICAL ENGINEER		
ELECTRICAL ENGINEER		

PROJECT:

RESIDENTIAL BUILDING
G+1P+7+ROOF

REVIEW STATUS: ☐ A ☐ B ☐ C ☐ D

DATE REVIEWED: _____

REVIEWED BY: _____

Rev	Date	Description	Drawn	Checked
AB	02/11/2019	AS BUILT DRAWING SUBMISSION	RCF	Engr. Hazem

CLIENT:

MR. MASOOD ABDULLA MOHD
ABDULAZIZ AL ZAROONI

LOCATION	PLOT No.
IC- PHASE 3	IC3-H-40

PRINCIPAL CONSULTANT:

NA ان به اركيكتس للاستشارات الهندسية
NA ARCHITECTS ENGINEERING CONSULTANCY

OFFICE 2601 / THE EXCHANGE TOWER
BUSINESS BAY - DUBAI - U.A.E
TEL: 04-2777625 P.O.BOX- 237347
www.naarchitects.net

MAIN CONTRACTOR:

MC ALMABNA CONTRACTING COMPANY

SUB CONTRACTOR:

MC ALMABNA CONTRACTING COMPANY

DRAWING TITLE:

5TH FLOOR PLAN

DRAWN BY: RCF	JOB NO: P-10	DATE: 02.11.2019
CHECKED BY: Engr. Hazem	SCALE: 1:100	SHEET SIZE: A1
PROJECT NO: NA/IC/B103	SHOP DRAWING NO:	REV: AB

AS BUILT



- GENERAL NOTES
1. THIS DRAWING IS THE PROPERTY OF :
na architects engineering consultancy
P.O.Box 237347, DUBAI.
IT IS FORBIDDEN TO PRODUCE ITS CONTENTS IN ANY FORM, EXCEPT FOR THE INTENDED PURPOSE.
 2. THIS DRAWING IS NOT TO BE SCALED. THE STATED DIMENSIONS ONLY ARE TO BE CONSIDERED.
 3. THE DISCREPANCIES ARE TO BE BROUGHT TO THE ATTENTION AND RESOLVED BY NA ARCHITECTS ENGINEERING CONSULTANCY BEFORE COMMENCEMENT OF ANY WORK.
 4. ALWAYS FOLLOWED WRITTEN DIMENSION.

LEGEND

KEY PLAN

- NO SMOKING
- BIN FOR PAPER
- BIN FOR PLASTIC
- BIN FOR METAL
- BIN FOR CARDBOARD
- BIN FOR GLASS

AS BUILT

CONTRACTORS REPRESENTATIVES	DATE	INITIALS
CM / PROJECT ENGINEER		
ARCHITECT		
STRUCTURAL ENGINEER		
SUBCONTRACTORS REPRESENTATIVES	DATE	INITIALS
MEP. COORDINATOR		
MECHANICAL ENGINEER		
ELECTRICAL ENGINEER		

PROJECT:

RESIDENTIAL BUILDING
G+1P+7+ROOF

REVIEW STATUS

DATE REVIEWED

REVIEWED BY

DATE:

Rev	Date	Description	Drawn	Checked
AB	02/11/2019	AS BUILT DRAWING SUBMISSION	RCF	Engr. Hazem

CLIENT:

MR. MASOOD ABDULLA MOHD
ABDULAZIZ AL ZAROONI

LOCATION

IC- PHASE 3

PLOT No.

IC3-H-40

PRINCIPAL CONSULTANT:

NA ARCHITECTS ENGINEERING CONSULTANCY

OFFICE 2601 / THE EXCHANGE TOWER
BUSINESS BAY - DUBAI - U.A.E
TEL: 04-2777820 P.O.BOX: 237347
WWW.NAARCHITECTS.NET

MAIN CONTRACTOR:

MC

ALMABNA CONTRACTING COMPANY

DUBAI, A.E.
TEL: 04-2555555
FAX: 04-2555555
P.O.BOX: 233146

SUB CONTRACTOR:

MC


ALMABNA CONTRACTING COMPANY

DUBAI, A.E.
TEL: 04-2555555
FAX: 04-2555555
P.O.BOX: 233146

DRAWING TITLE:

6TH FLOOR PLAN


DRAWN BY:	JOB NO:	DATE:
RCF	P-10	02.11.2019
CHECKED BY:	SCALE:	SHEET SIZE:
Engr. Hazem	1:100	A1
PROJECT NO:	SHOP DRAWING NO:	REV:
NA/IC/B103 NA/IC/B103/15		AB

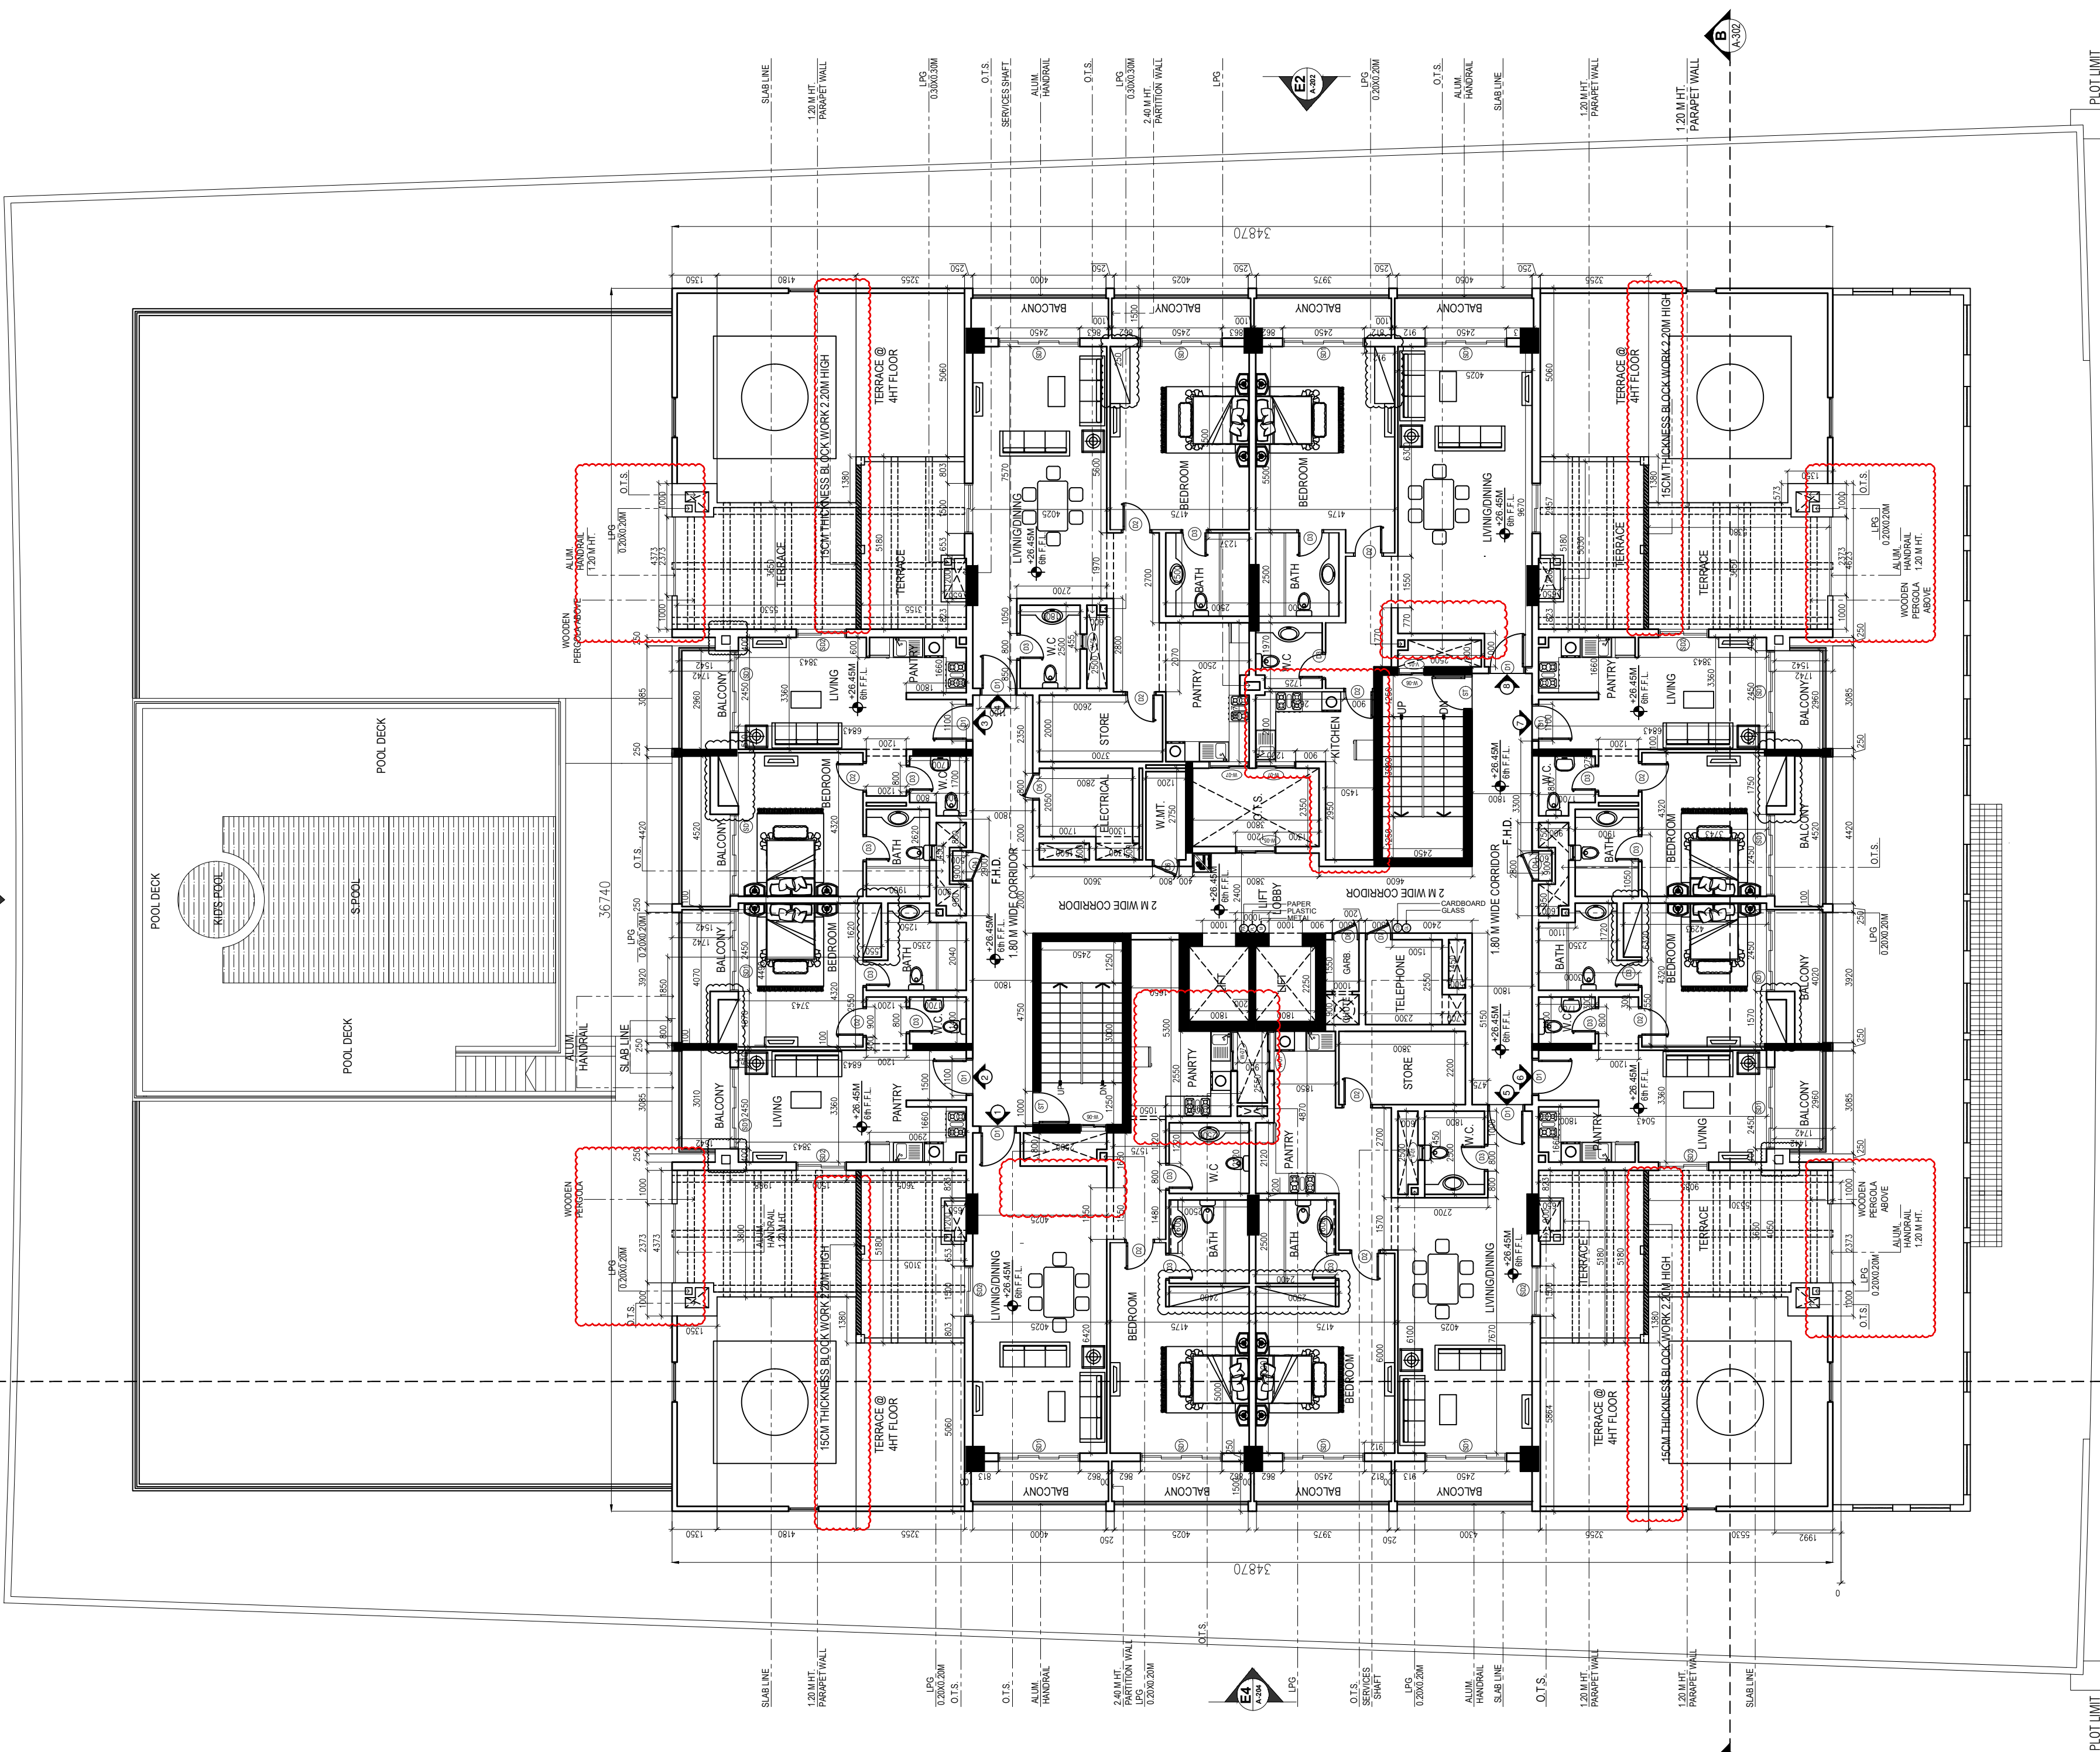

6TH FLOOR PLAN

A-108

AS BUILT

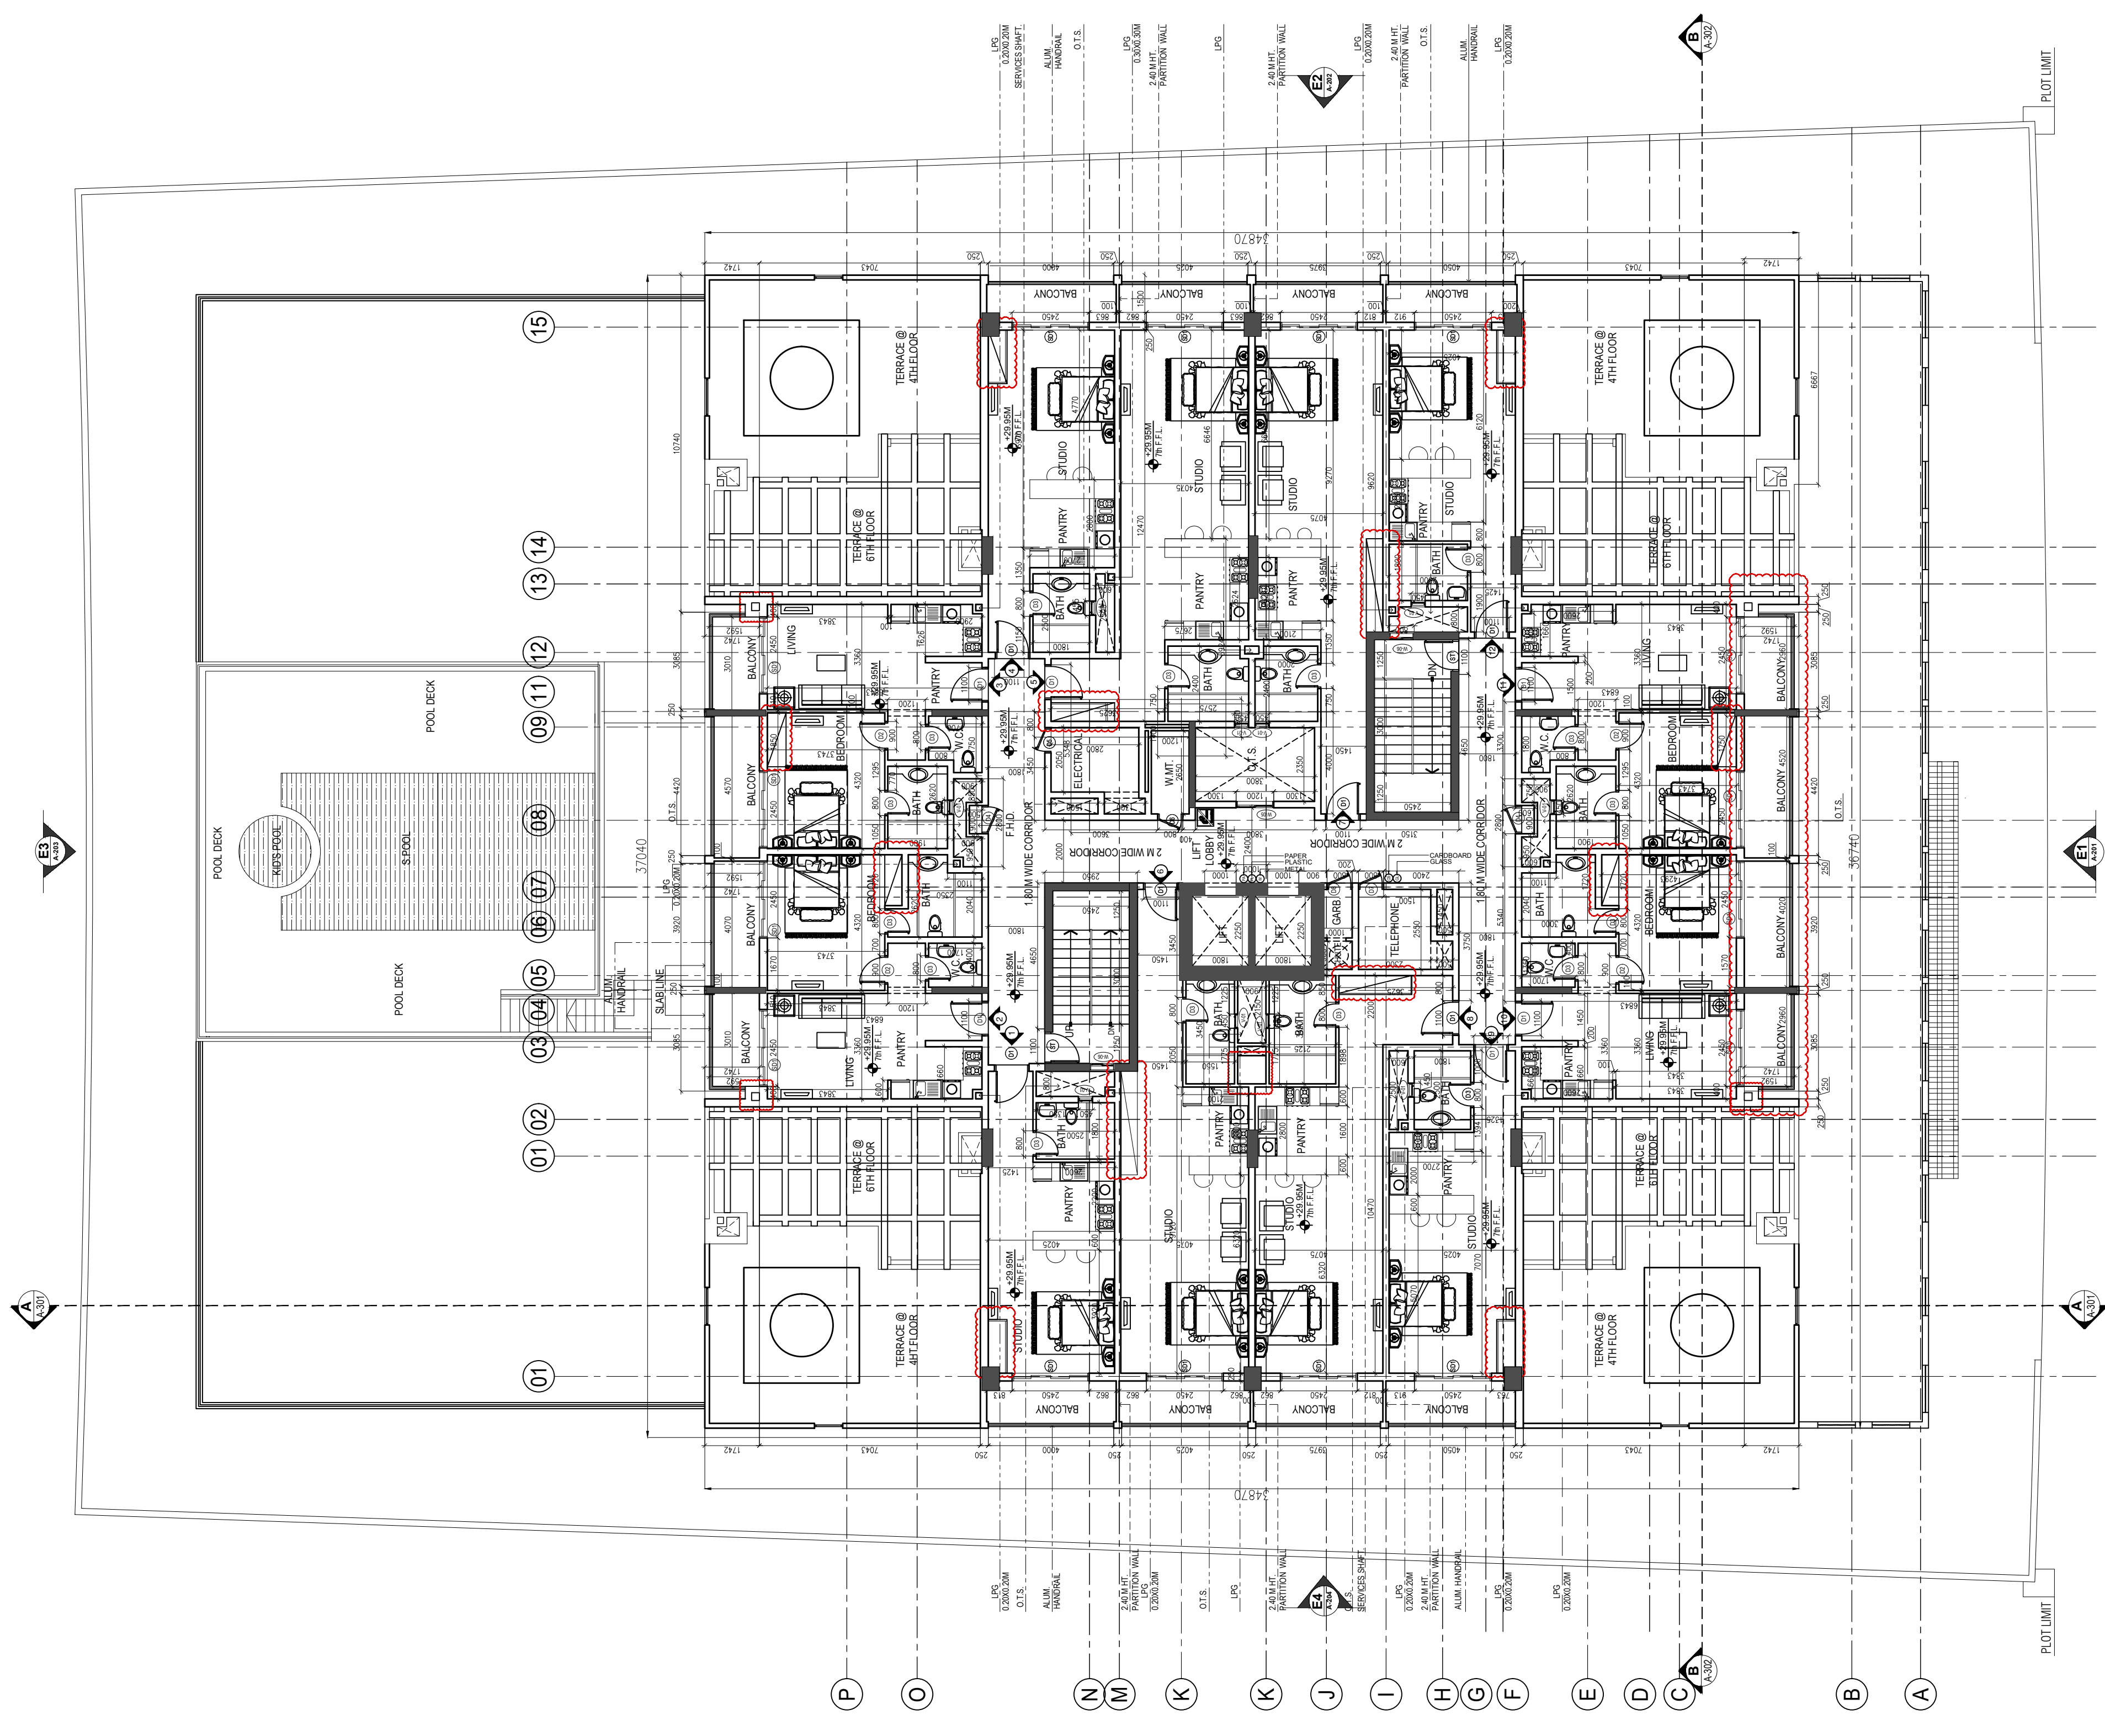

- GENERAL NOTES
1. THIS DRAWING IS THE PROPERTY OF :
na architects engineering consultancy
P.O.Box 237347, DUBAI.
IT IS FORBIDDEN TO PRODUCE IT'S CONTENTS IN
ANY FORM, EXCEPT FOR THE INTENDED PURPOSE.
 2. THIS DRAWING IS NOT TO BE SCALED. THE STATED
DIMENSIONS ONLY ARE TO BE CONSIDERED.
 3. THE DISCREPANCIES ARE TO BE BROUGHT TO THE
ATTENTION AND RESOLVED BY NA ARCHITECTS
ENGINEERING CONSULTANCY BEFORE
COMMENCEMENT OF ANY WORK.
 4. ALWAYS FOLLOWED WRITTEN DIMENSION.

LEGEND

KEY PLAN

- NO SMOKING
- BIN FOR PAPER
- BIN FOR PLASTIC
- BIN FOR METAL
- BIN FOR CARDBOARD
- BIN FOR GLASS

AS BUILT

CONTRACTORS REPRESENTATIVES	DATE	INITIALS
CM / PROJECT ENGINEER		
ARCHITECT		
STRUCTURAL ENGINEER		
SUBCONTRACTORS REPRESENTATIVES	DATE	INITIALS
MEP. COORDINATOR		
MECHANICAL ENGINEER		
ELECTRICAL ENGINEER		

PROJECT:

RESIDENTIAL BUILDING
G+1P+7+ROOF

REVIEW STATUS

DATE REVIEWED

REVIEWED BY

DATE:

Rev	Date	Description	Drawn	Checked
AB	02/11/2019	AS BUILT DRAWING SUBMISSION	RCF	Engr. Hazem

CLIENT:

MR. MASOOD ABDULLA MOHD
ABDULAZIZ AL ZAROONI

LOCATION	PLOT No.
IC- PHASE 3	IC3-H-40

PRINCIPAL CONSULTANT:

NA **نايه آر كيتكس للاستشارات الهندسية**
NA ARCHITECTS ENGINEERING CONSULTANCY

OFFICE 2801 / THE EXCHANGE TOWER
BUSINESS BAY - DUBAI - U.A.E
TEL: 04-2777820 P.O.BOX: 237347
WWW.NAARCHITECTS.NET

MAIN CONTRACTOR:

MC **ALMABNA CONTRACTING COMPANY**

DUBAI, U.A.E
TEL: 04-2555555
FAX: 04-2555555
P.O.BOX: 233146

SUB CONTRACTOR:

MC **ALMABNA CONTRACTING COMPANY**

DUBAI, U.A.E
TEL: 04-2555555
FAX: 04-2555555
P.O.BOX: 233146

DRAWING TITLE:

7TH FLOOR PLAN

DRAWN BY: RCF	JOB NO: P-10	DATE: 02.11.2019
CHECKED BY: Engr. Hazem	SCALE: 1:100	SHEET SIZE: A1
PROJECT NO: NA/IC/B103 NA/IC/B103/15	SHOP DRAWING NO:	REV: AB

AS BUILT



- GENERAL NOTES
1. THIS DRAWING IS THE PROPERTY OF :
na architects engineering consultancy
P.O.Box 237347, DUBAI.
IT IS FORBIDDEN TO PRODUCE IT'S CONTENTS IN ANY FORM, EXCEPT FOR THE INTENDED PURPOSE.
 2. THIS DRAWING IS NOT TO BE SCALED. THE STATED DIMENSIONS ONLY ARE TO BE CONSIDERED.
 3. THE DISCREPANCIES ARE TO BE BROUGHT TO THE ATTENTION AND RESOLVED BY NA ARCHITECTS ENGINEERING CONSULTANCY BEFORE COMMENCEMENT OF ANY WORK.
 4. ALWAYS FOLLOWED WRITTEN DIMENSION.

LEGEND

KEY PLAN



— NO SMOKING

AS BUILT

CONTRACTORS REPRESENTATIVES	DATE	INITIALS
CM / PROJECT ENGINEER		
ARCHITECT		
STRUCTURAL ENGINEER		
SUBCONTRACTORS REPRESENTATIVES	DATE	INITIALS
MEP. COORDINATOR		
MECHANICAL ENGINEER		
ELECTRICAL ENGINEER		

PROJECT:

RESIDENTIAL BUILDING
G+1P+7+ROOF

REVIEW STATUS: ☐ A ☐ B ☐ C ☐ D

DATE REVIEWED: _____

REVIEWED BY: _____

DATE: _____

Rev	Date	Description	Drawn	Checked
AB	02/11/2019	AS BUILT DRAWING SUBMISSION	RCF	Engr. Hazem

CLIENT:

MR. MASOOD ABDULLA MOHD
ABDULAZIZ AL ZAROONI

LOCATION	PLOT No.
IC- PHASE 3	IC3-H-40

PRINCIPAL CONSULTANT:

NA ان ايه ار كيتكتس للاستشارات الهندسية
NA ARCHITECTS ENGINEERING CONSULTANCY

OFFICE 2601 / THE EXCHANGE TOWER
BUSINESS BAY - DUBAI - U.A.E
TEL: 04-2777820 P.O.BOX: 237347
WWW.NAARCHITECTS.NET

MAIN CONTRACTOR:

MC ALMABNA CONTRACTING COMPANY

DUBAI, A.E.
TEL: 04-2777820
P.O.BOX: 237347

SUB CONTRACTOR:

MC ALMABNA CONTRACTING COMPANY


DUBAI, A.E.
TEL: 04-2777820
P.O.BOX: 237347


DRAWING TITLE:

ROOF FLOOR PLAN


DRAWN BY: RCF	JOB NO: P-10	DATE: 02.11.2019
CHECKED BY: Engr. Hazem	SCALE: 1:100	SHEET SIZE: A1
PROJECT NO: NA/IC/B103 NA/IC/B103/15	SHOP DRAWING NO:	REV: AB

AS BUILT

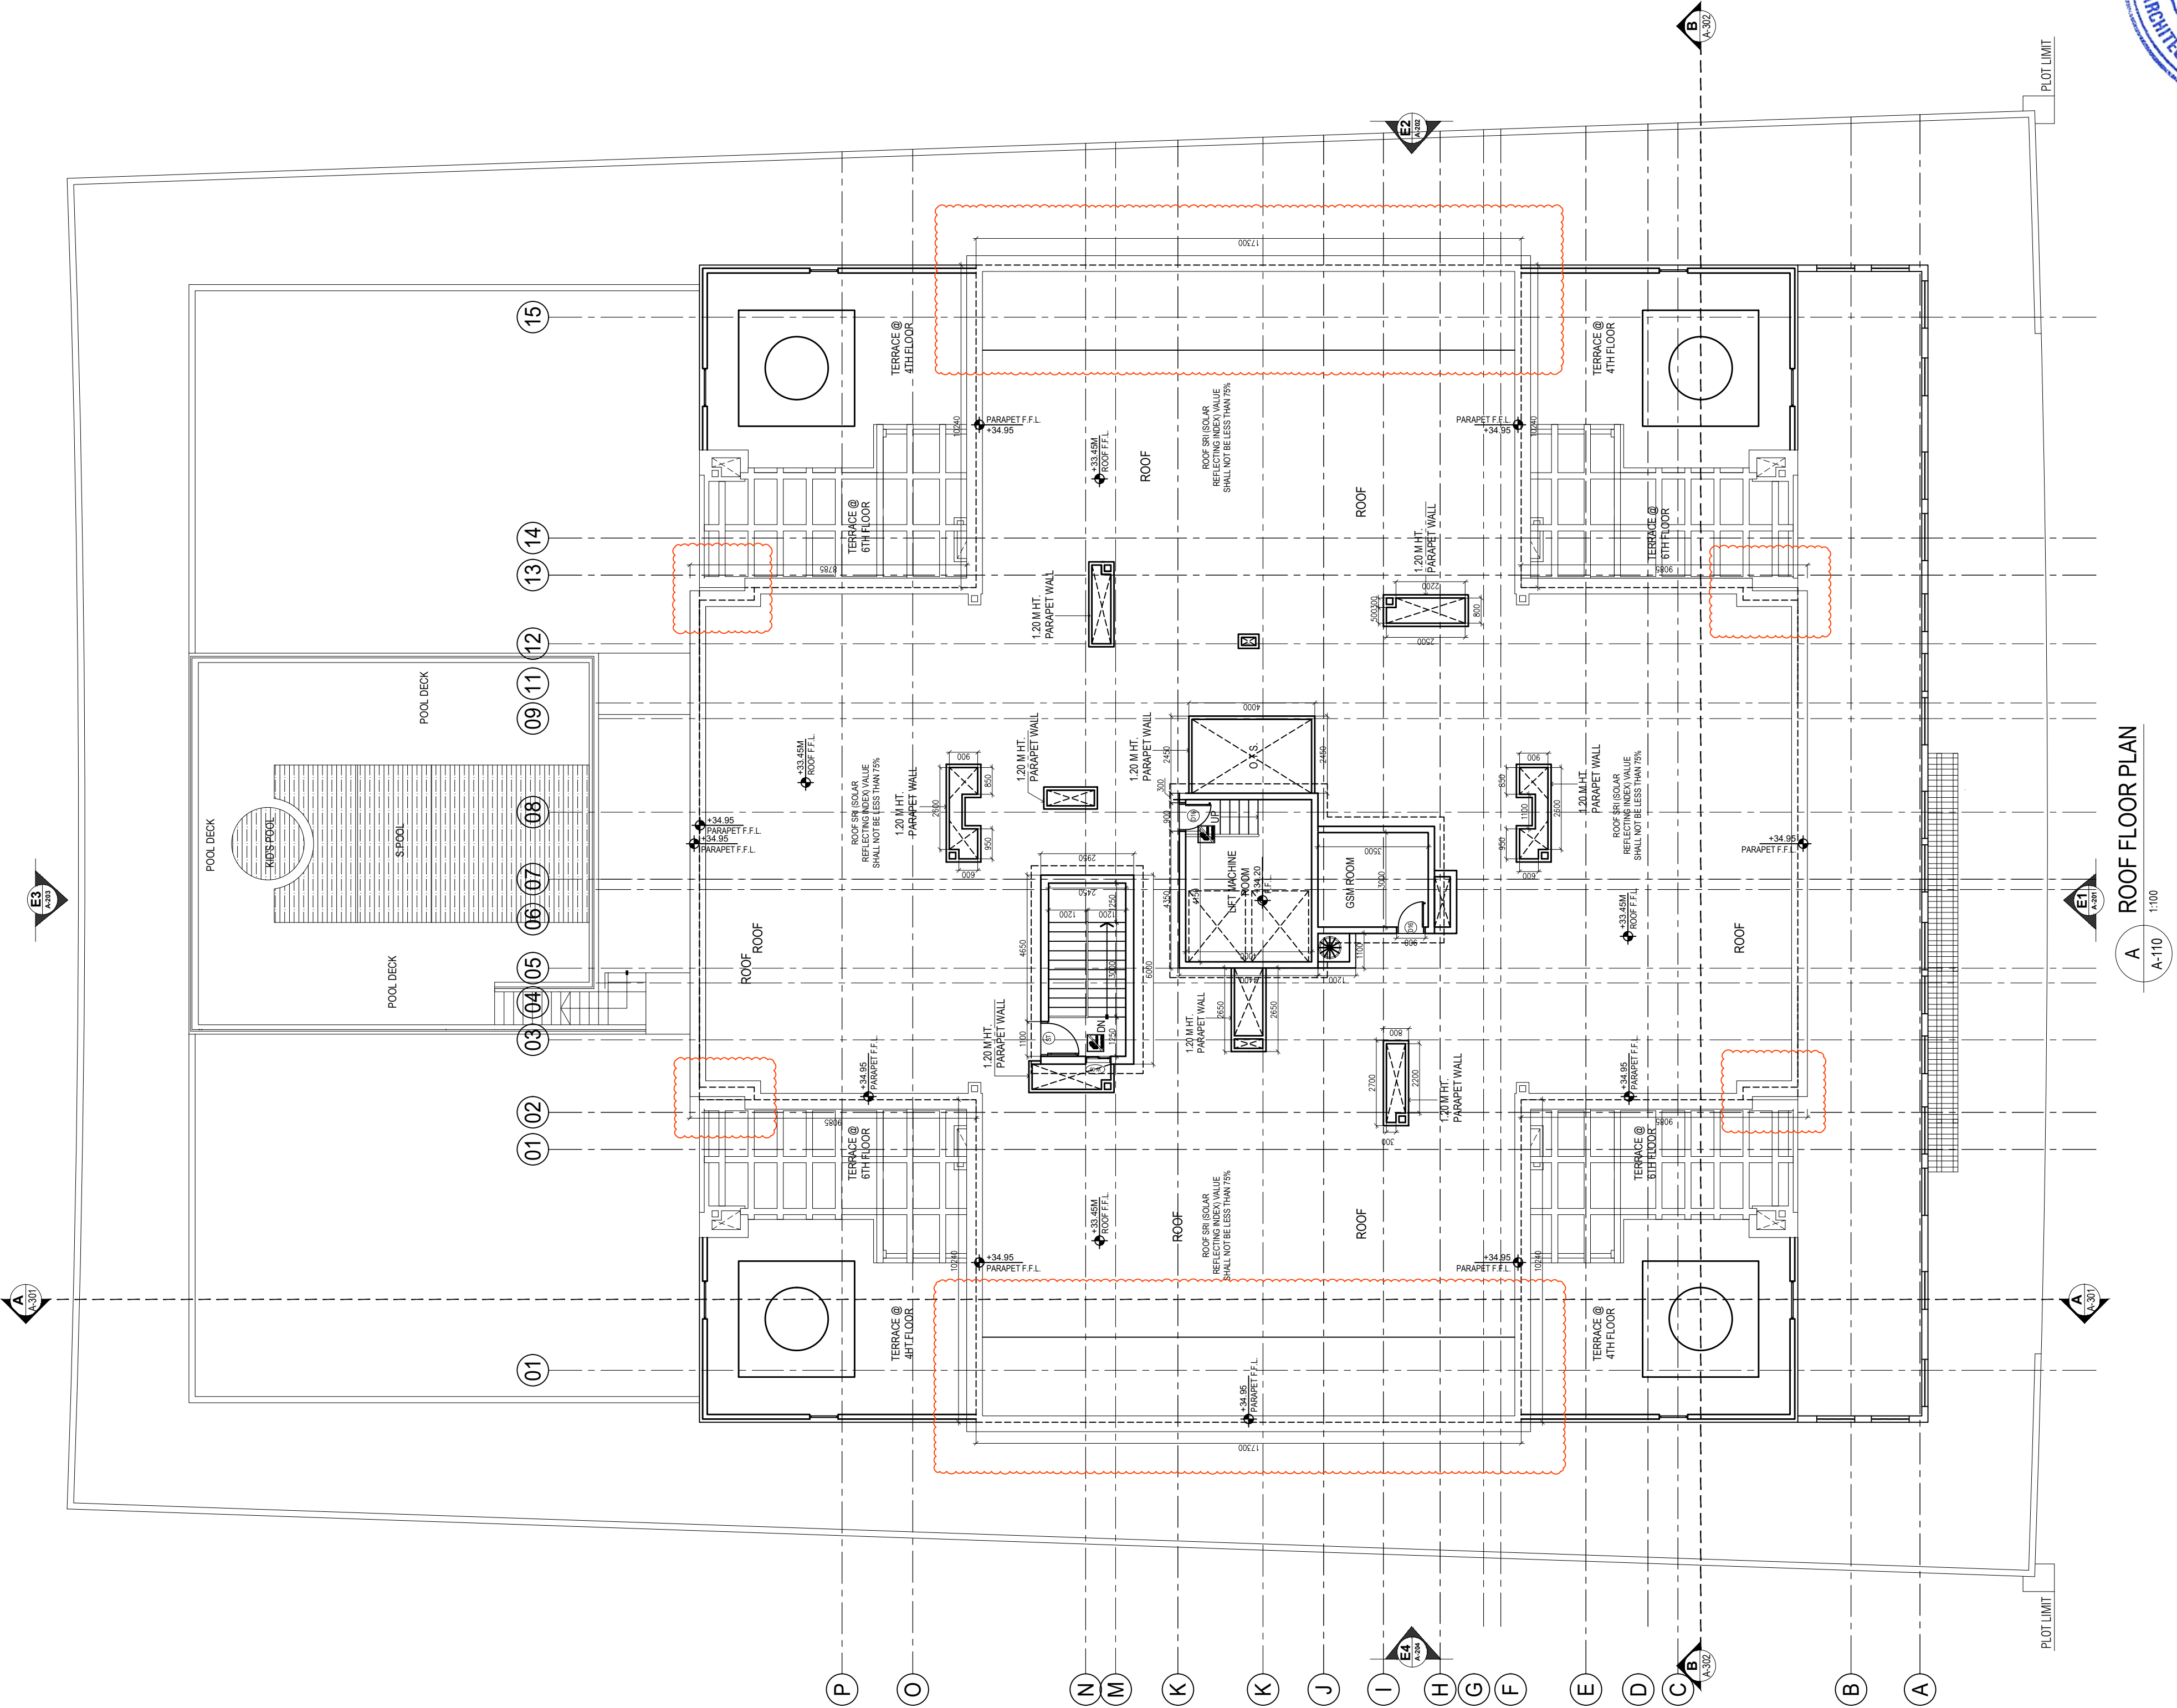

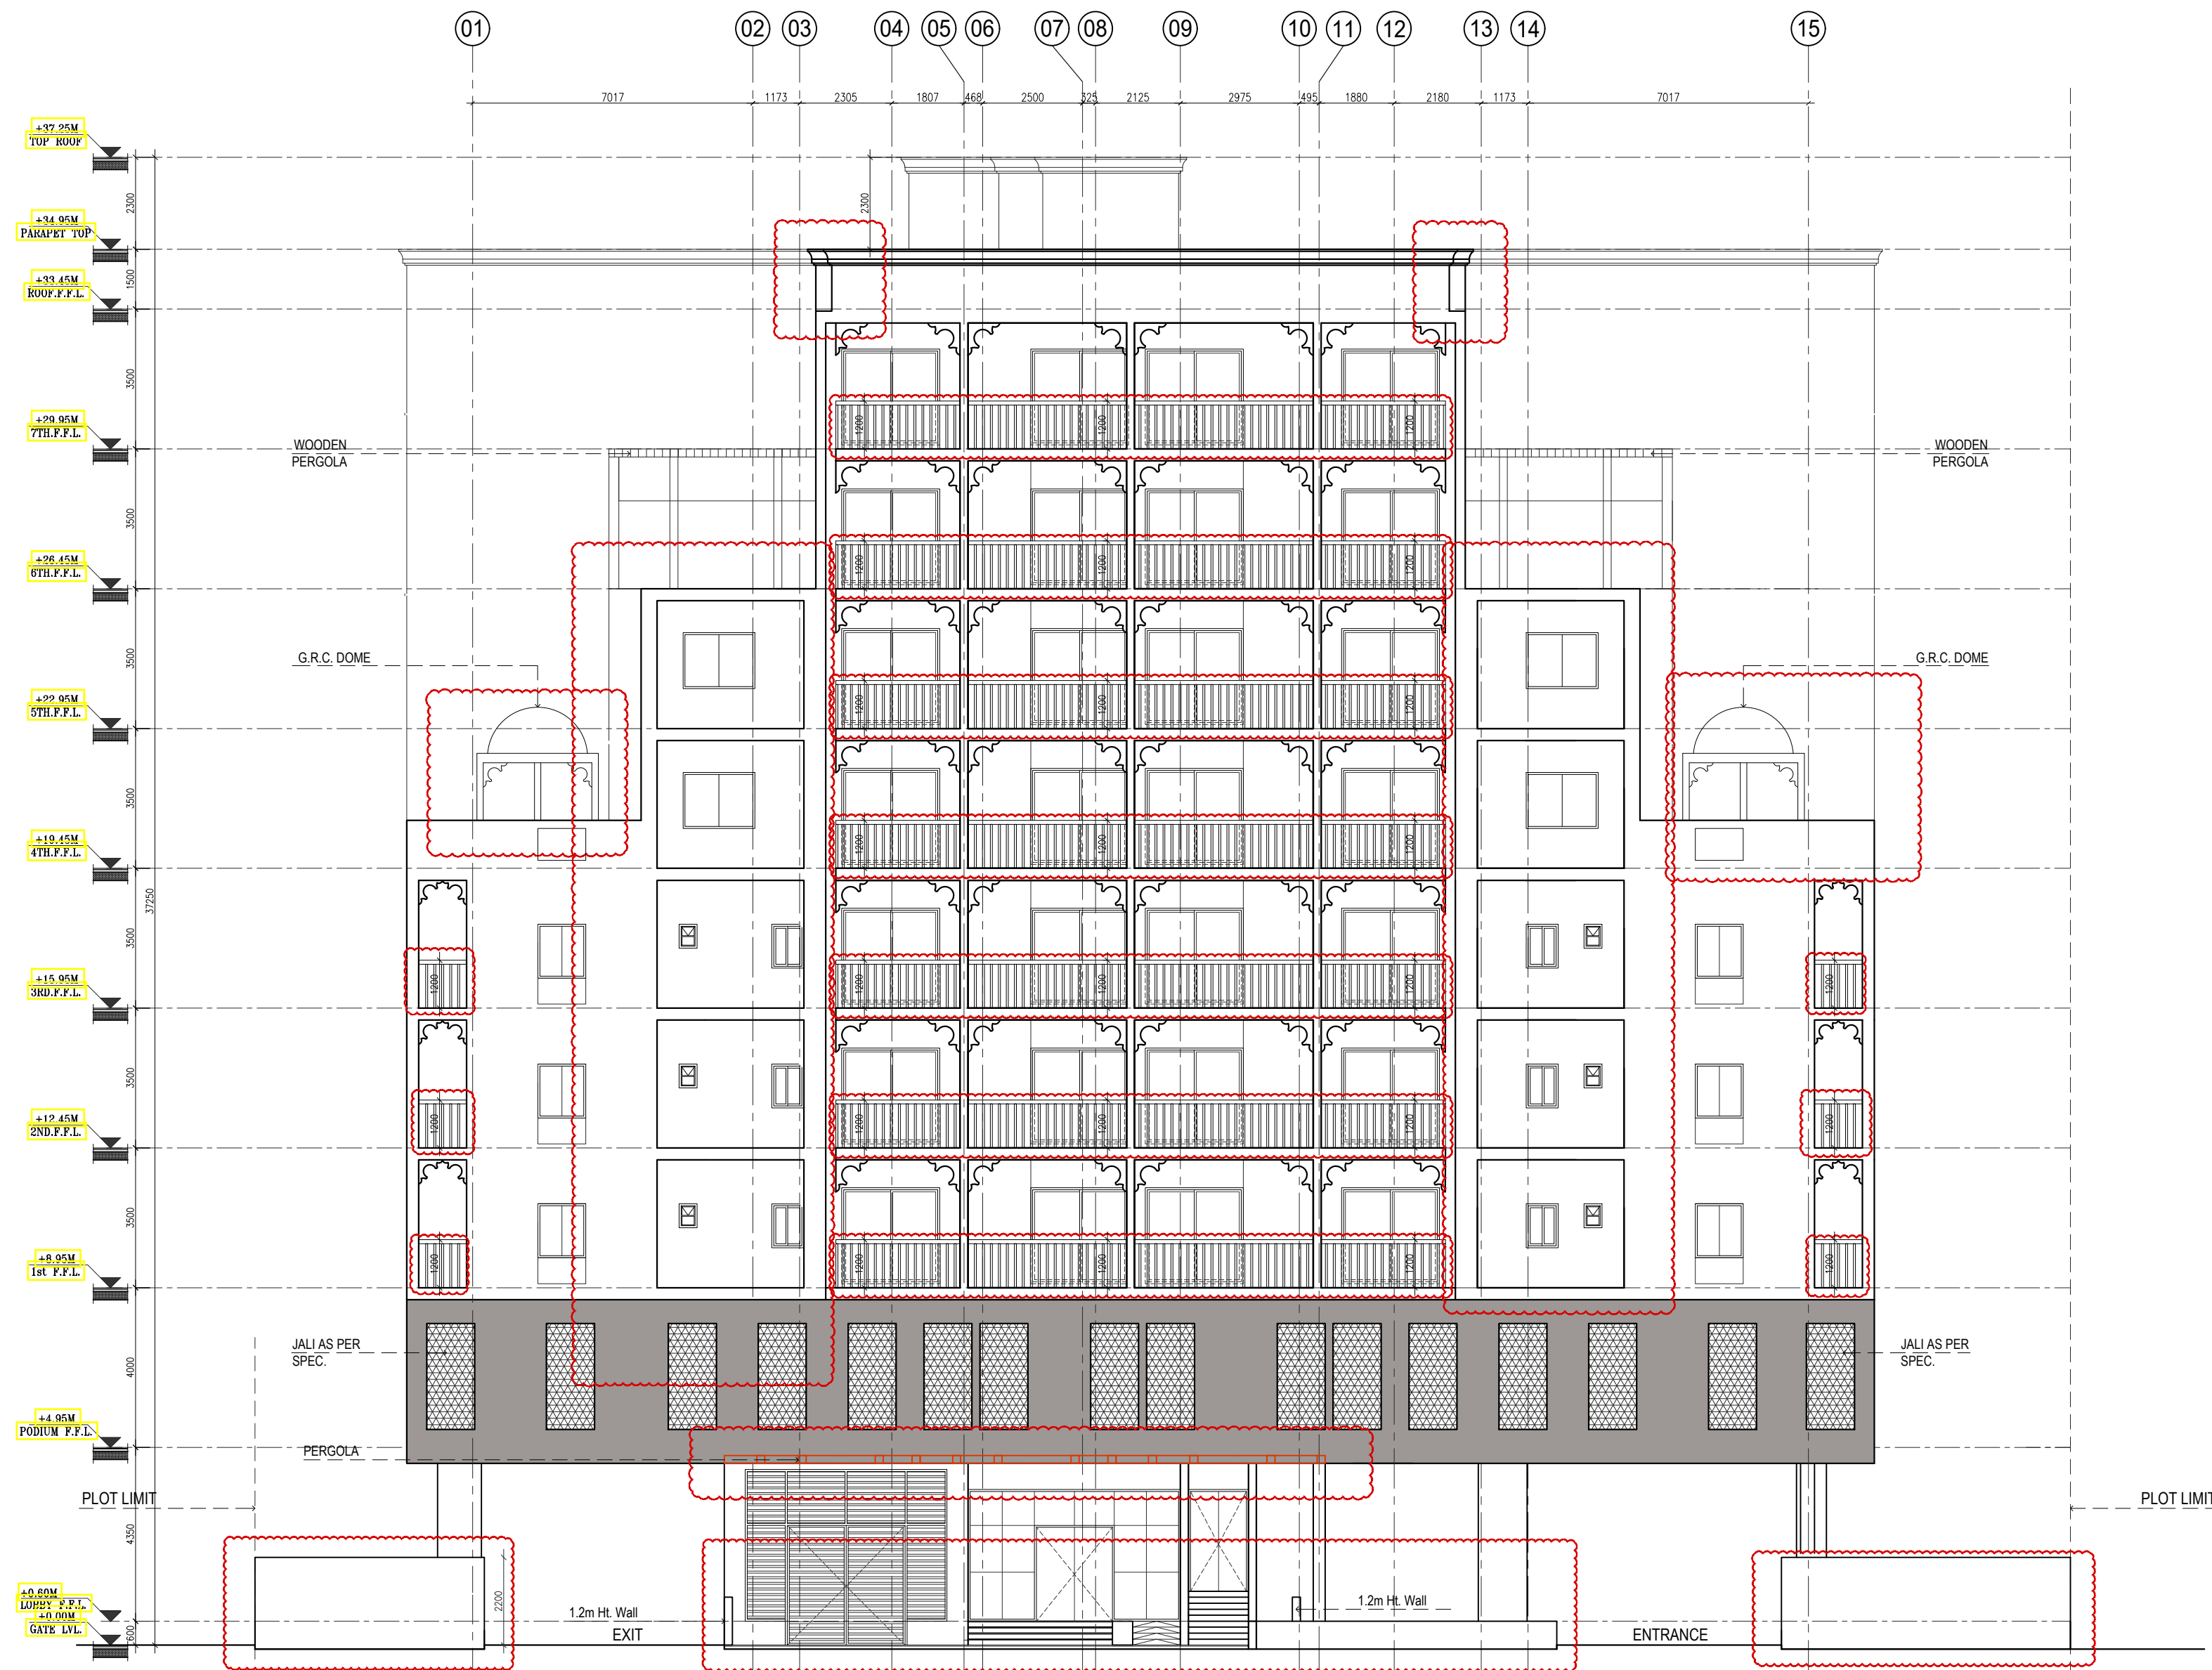

A ELEVATION 1
A-201 1:100

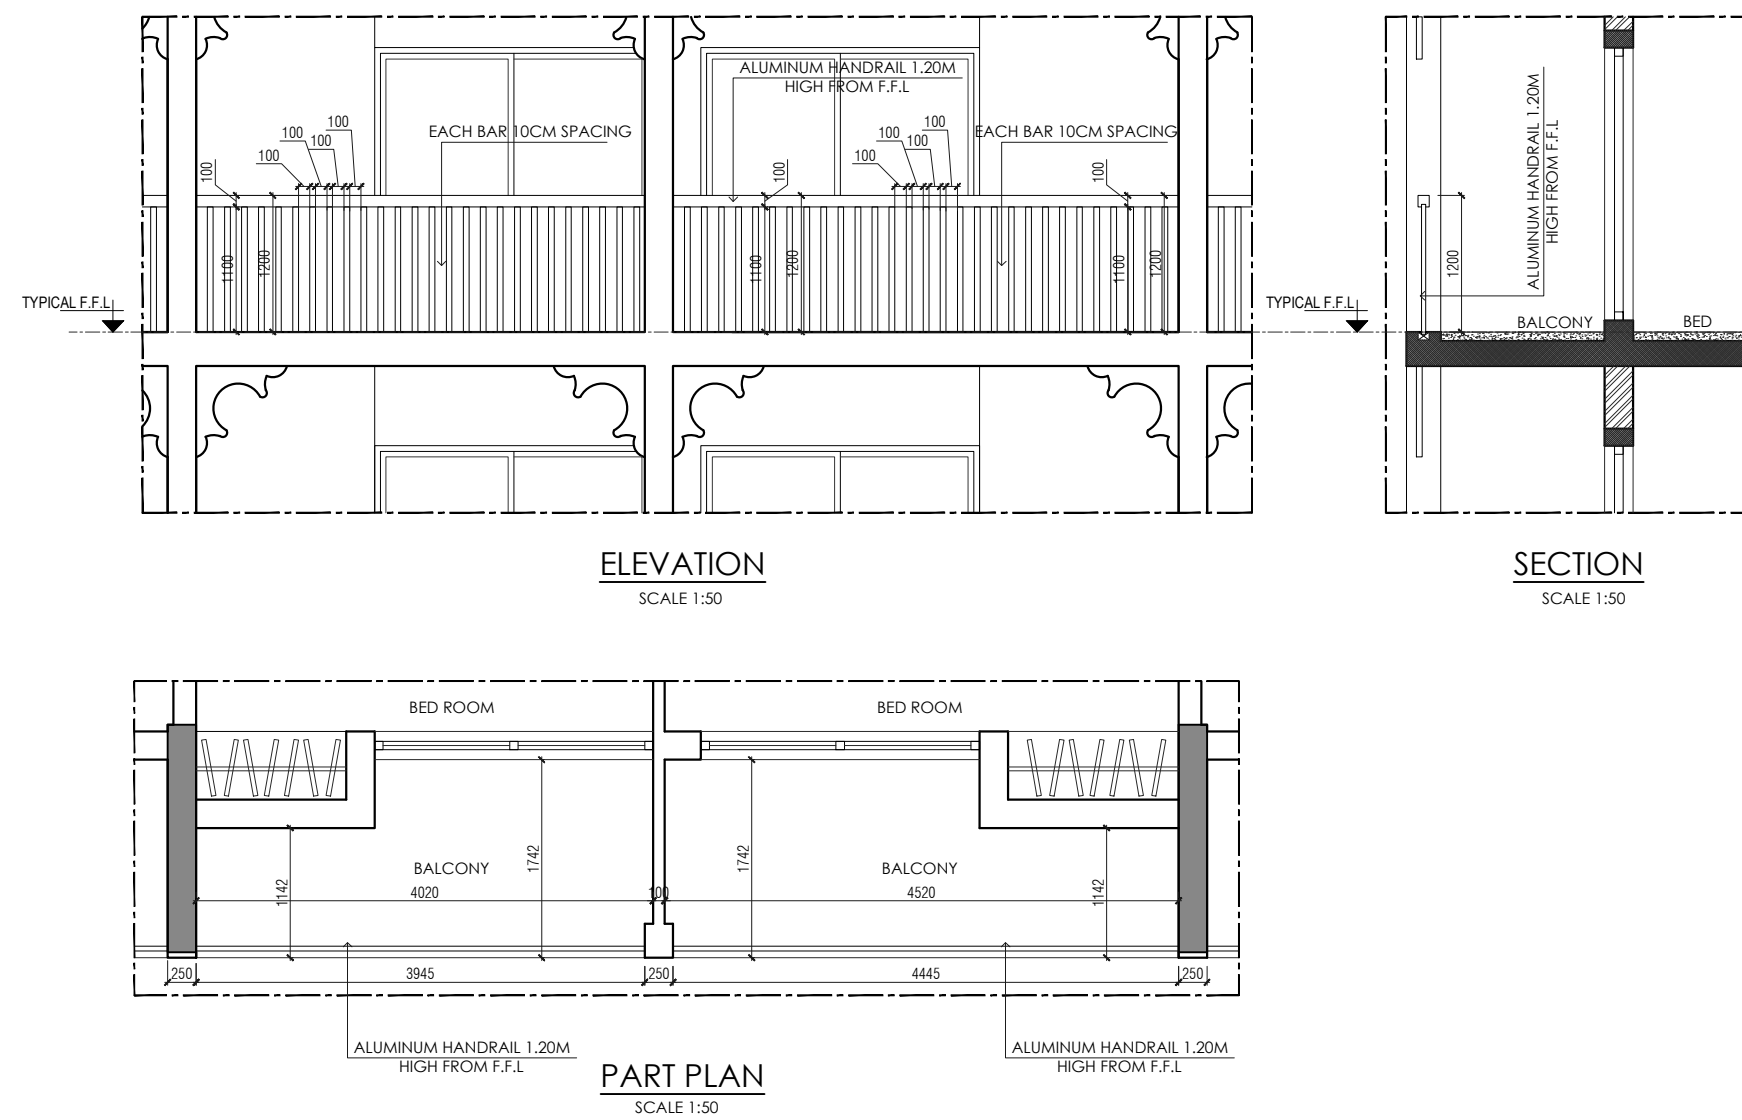

AS BUILT

- GENERAL NOTES
1. THIS DRAWING IS THE PROPERTY OF :
na architects engineering consultancy
P.O.Box 237347, DUBAI.
IT IS FORBIDDEN TO PRODUCE IT'S CONTENTS IN
ANY FORM, EXCEPT FOR THE INTENDED PURPOSE.
 2. THIS DRAWING IS NOT TO BE SCALED. THE STATED
DIMENSIONS ONLY ARE TO BE CONSIDERED.
 3. THE DISCREPANCIES ARE TO BE BROUGHT TO THE
ATTENTION AND RESOLVED BY NA ARCHITECTS
ENGINEERING CONSULTANCY BEFORE
COMMENCEMENT OF ANY WORK.
 4. ALWAYS FOLLOWED WRITTEN DIMENSION.

LEGEND

KEY PLAN

AS BUILT

CONTRACTORS REPRESENTATIVES	DATE	INITIALS
CM / PROJECT ENGINEER		
ARCHITECT		
STRUCTURAL ENGINEER		
SUBCONTRACTORS REPRESENTATIVES	DATE	INITIALS
MEP. COORDINATOR		
MECHANICAL ENGINEER		
ELECTRICAL ENGINEER		

PROJECT:

RESIDENTIAL BUILDING
G+1P+7+ROOF

REVIEW STATUS ☐ A ☐ B ☐ C ☐ D

DATE REVIEWED

REVIEWED BY

DATE:

Rev	Date	Description	Drawn	Checked
AB	02/11/2019	AS BUILT DRAWING SUBMISSION	RCF	Engr. Hazem

CLIENT :

MR. MASOOD ABDULLA MOHD
ABDULAZIZ AL ZAROONI

LOCATION

IC- PHASE 3

PLOT No.

IC3-H-40

PRINCIPAL CONSULTANT:

NA ARCHITECTS ENGINEERING CONSULTANCY

OFFICE 2601 / THE EXCHANGE TOWER
BUSINESS BAY - DUBAI - U.A.E
TEL: 04-2777820 P.O.BOX: 237347
WWW.NAARCHITECTS.NET

MAIN CONTRACTOR :

MC

ALMABNA CONTRACTING COMPANY

SUB CONTRACTOR :


MC

ALMABNA CONTRACTING COMPANY

DRAWING TITLE :

ELEVATION 1

DRAWN BY: RCF	JOB NO: P-10	DATE: 02.11.2019
CHECKED BY: Engr. Hazem	SCALE: 1:100	SHEET SIZE: A1
PROJECT NO: NA/IC/B103 NA/IC/B103/15	SHOP DRAWING NO:	REV: AB

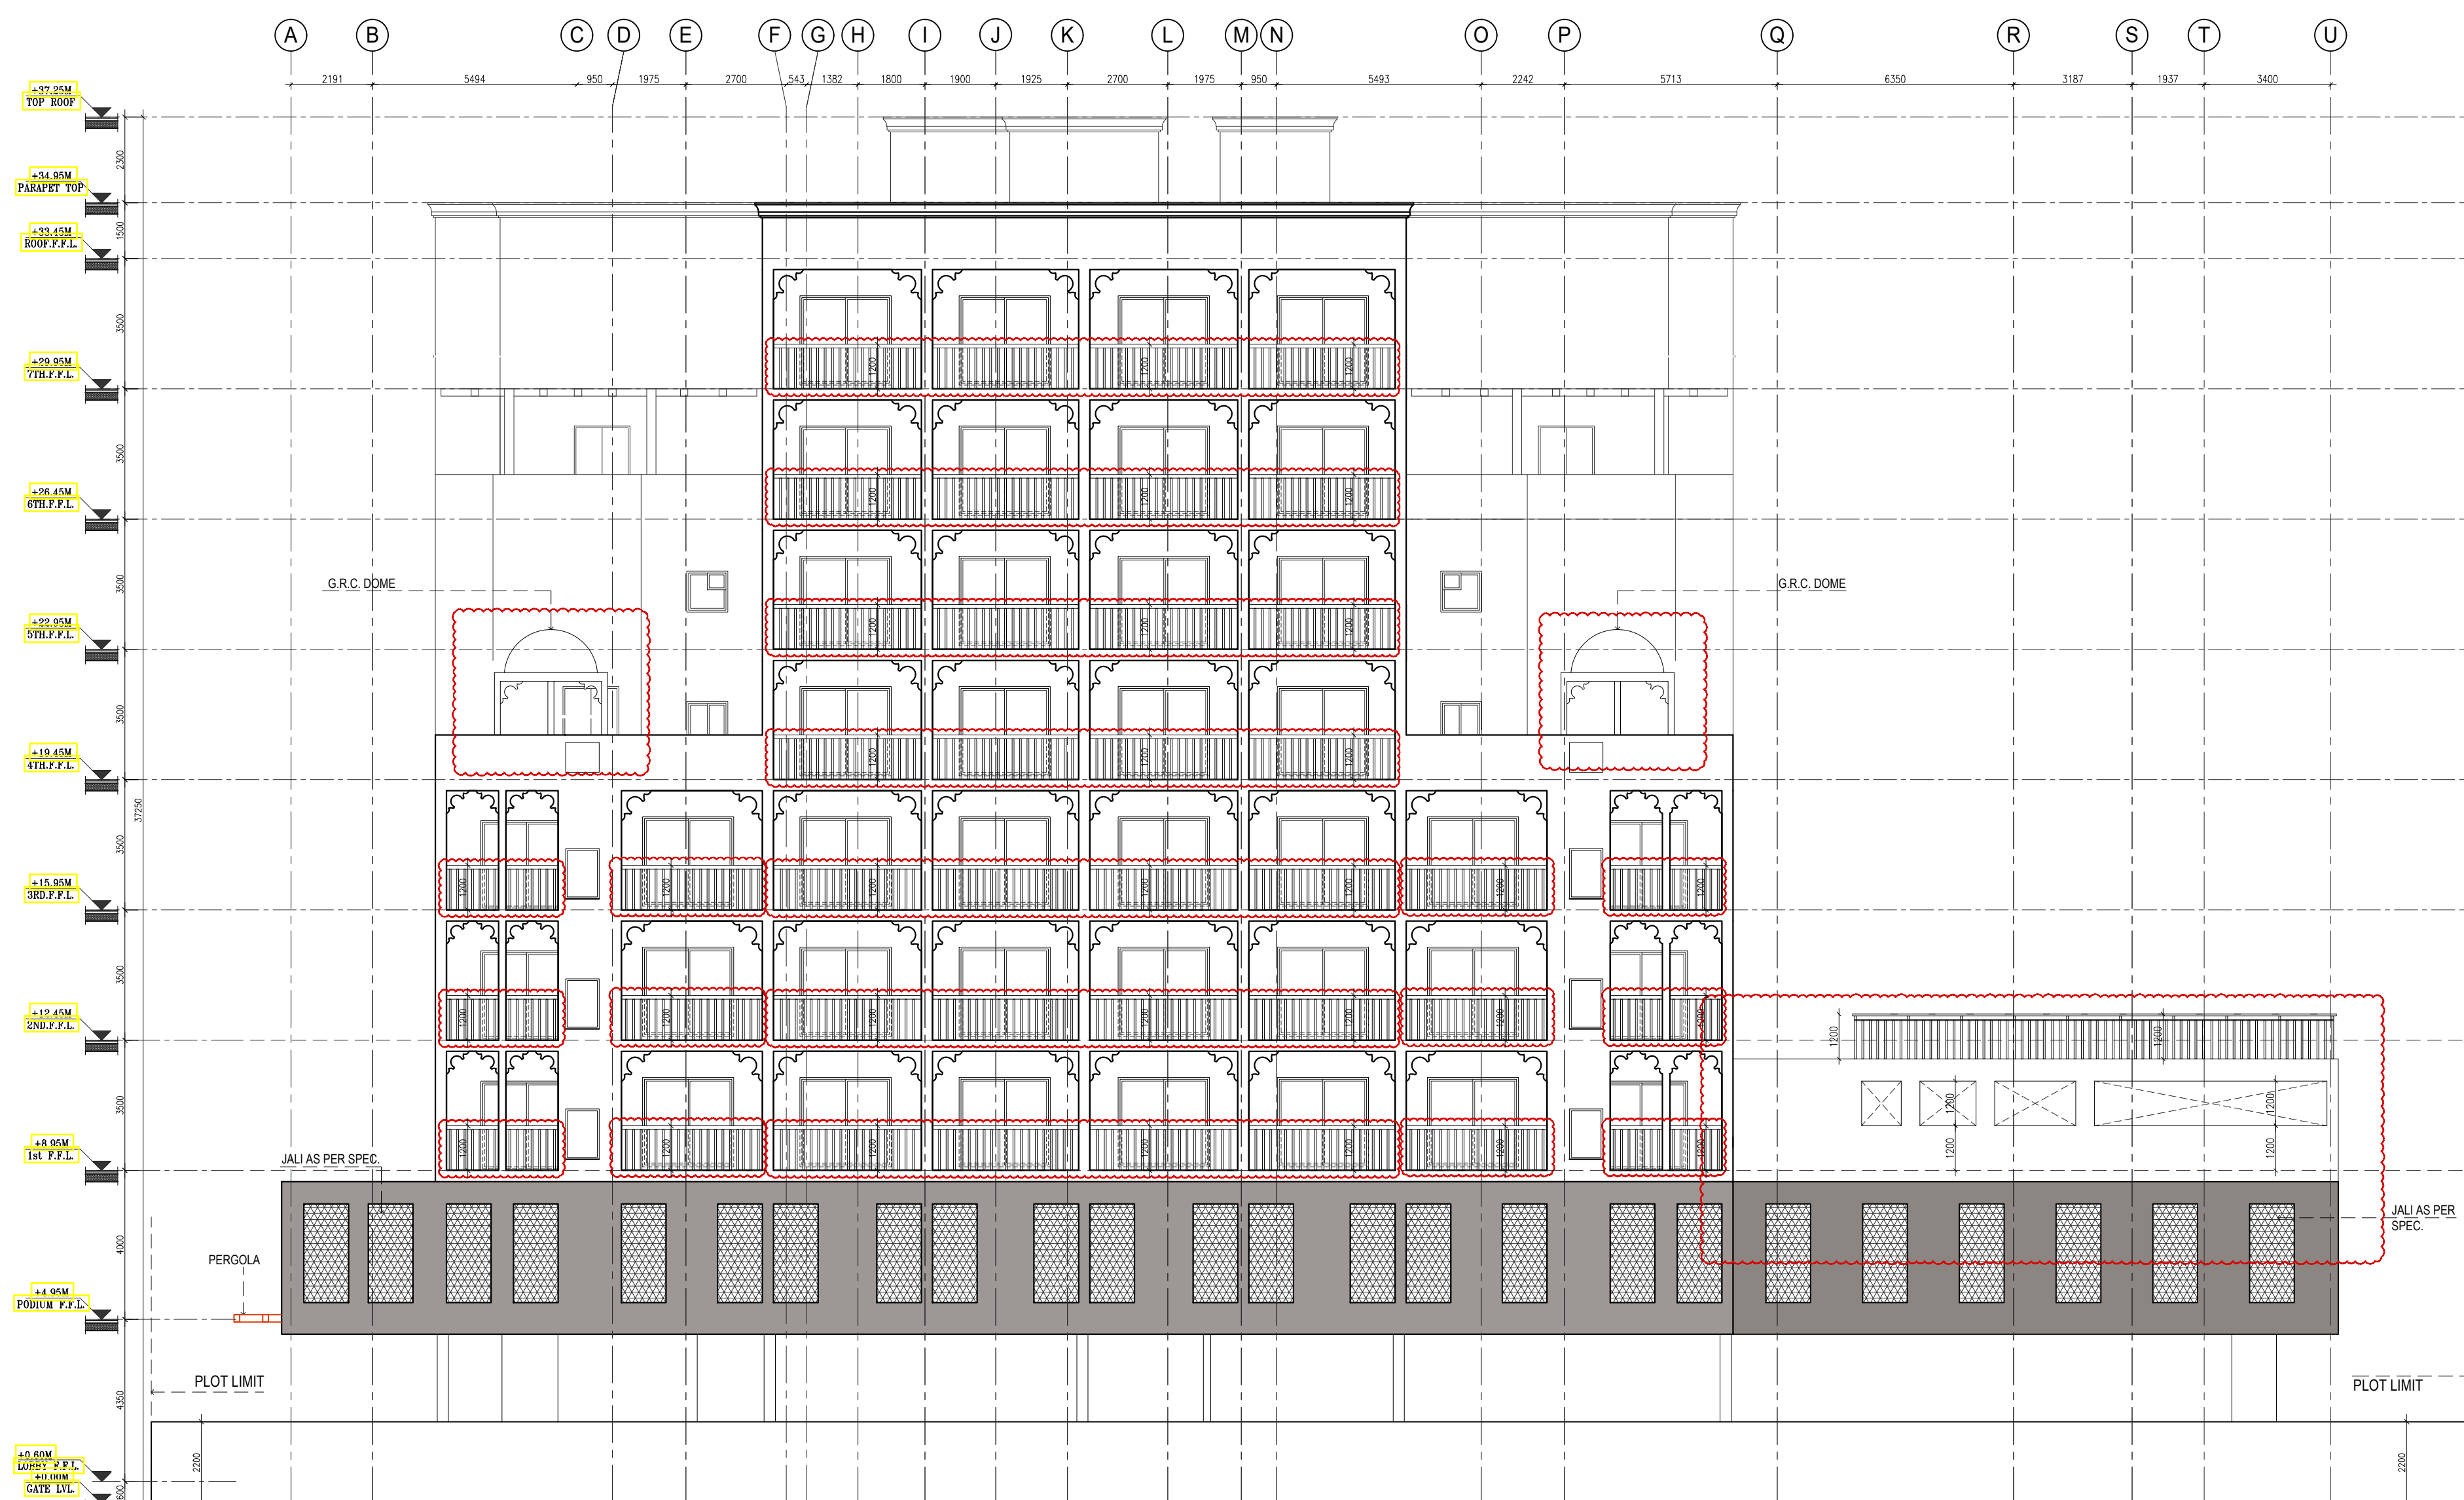

AS BUILT

GENERAL NOTES

- 1.** THIS DRAWING IS THE PROPERTY OF :
na architects engineering consultancy
P.O.Box 237347, DUBAI.

IT IS FORBIDDEN TO PRODUCE IT'S CONTENTS IN
ANY FORM, EXCEPT FOR THE INTENDED PURPOSE.
- 2.** THIS DRAWING IS NOT TO BE SCALED. THE STATED
DIMENSIONS ONLY ARE TO BE CONSIDERED.
- 3.** THE DISCREPANCIES ARE TO BE BROUGHT TO THE
ATTENTION AND RESOLVED BY NA ARCHITECTS
ENGINEERING CONSULTANCY BEFORE
COMMENCEMENT OF ANY WORK.
- 4.** ALWAYS FOLLOWED WRITTEN DIMENSION.

LEGEND

KEY PLAN

AS BUILT

CONTRACTORS REPRESENTATIVES	DATE	INITIALS
CM / PROJECT ENGINEER		
ARCHITECT		
STRUCTURAL ENGINEER		
SUBCONTRACTORS REPRESENTATIVES	DATE	INITIALS
MEP. COORDINATOR		
MECHANICAL ENGINEER		
ELECTRICAL ENGINEER		

PROJECT:	
RESIDENTIAL BUILDING G+1P+7+ROOF	
REVIEW STATUS	☐ A ☐ B ☐ C ☐ D
DATE REVIEWED	
REVIEWED BY	
	DATE:

AB	02/11/2019	AS BUILT DRAWING SUBMISSION	RCF	Engr. Haz
Rev	Date	Description	Drawn	Cheke

CLIENT :

MR. MASOOD ABDULLA MOHD
ABDULAZIZ AL ZAROONI


LOCATION	PLOT No.
IC- PHASE 3	IC3-H-40

PRINCIPAL CONSULTANT:

NA
ARCHITECTS


ان ايه ار كيمكتس للاستشارات الهندسية
NA ARCHITECTS ENGINEERING CONSULTANCY

OFFICE 2001 / THE EXCHANGE TOWER
BUSINESS BAY - DUBAI - U.A.E.
TEL: 64-2777620 P.O.BOX: 207347
www.naarchitects.net

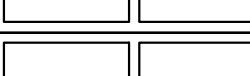MAIN CONTRACTOR :		ALMABNA CONTRACTING COMPANY QATAR/ALUJIL TEL: 971-4-4444444 FAX: 971-4-4444444 P.O. BOX: 123456
SUB CONTRACTOR :		ALMABNA CONTRACTING COMPANY QATAR/ALUJIL TEL: 971-4-4444444 FAX: 971-4-4444444 P.O. BOX: 123456

DRAWING TITLE : **ELEVATION 2**

DRAWN BY: RCF		JOB NO: P-10	DATE: 02.11.2019
CHECKED BY: Engr. Hazem		SCALE: 1:100	SHEET SIZE: A1
PROJECT NO: NA/IC/B103		SHOP DRAWING NO:	
NA/IC/B103/15		REV: AB	

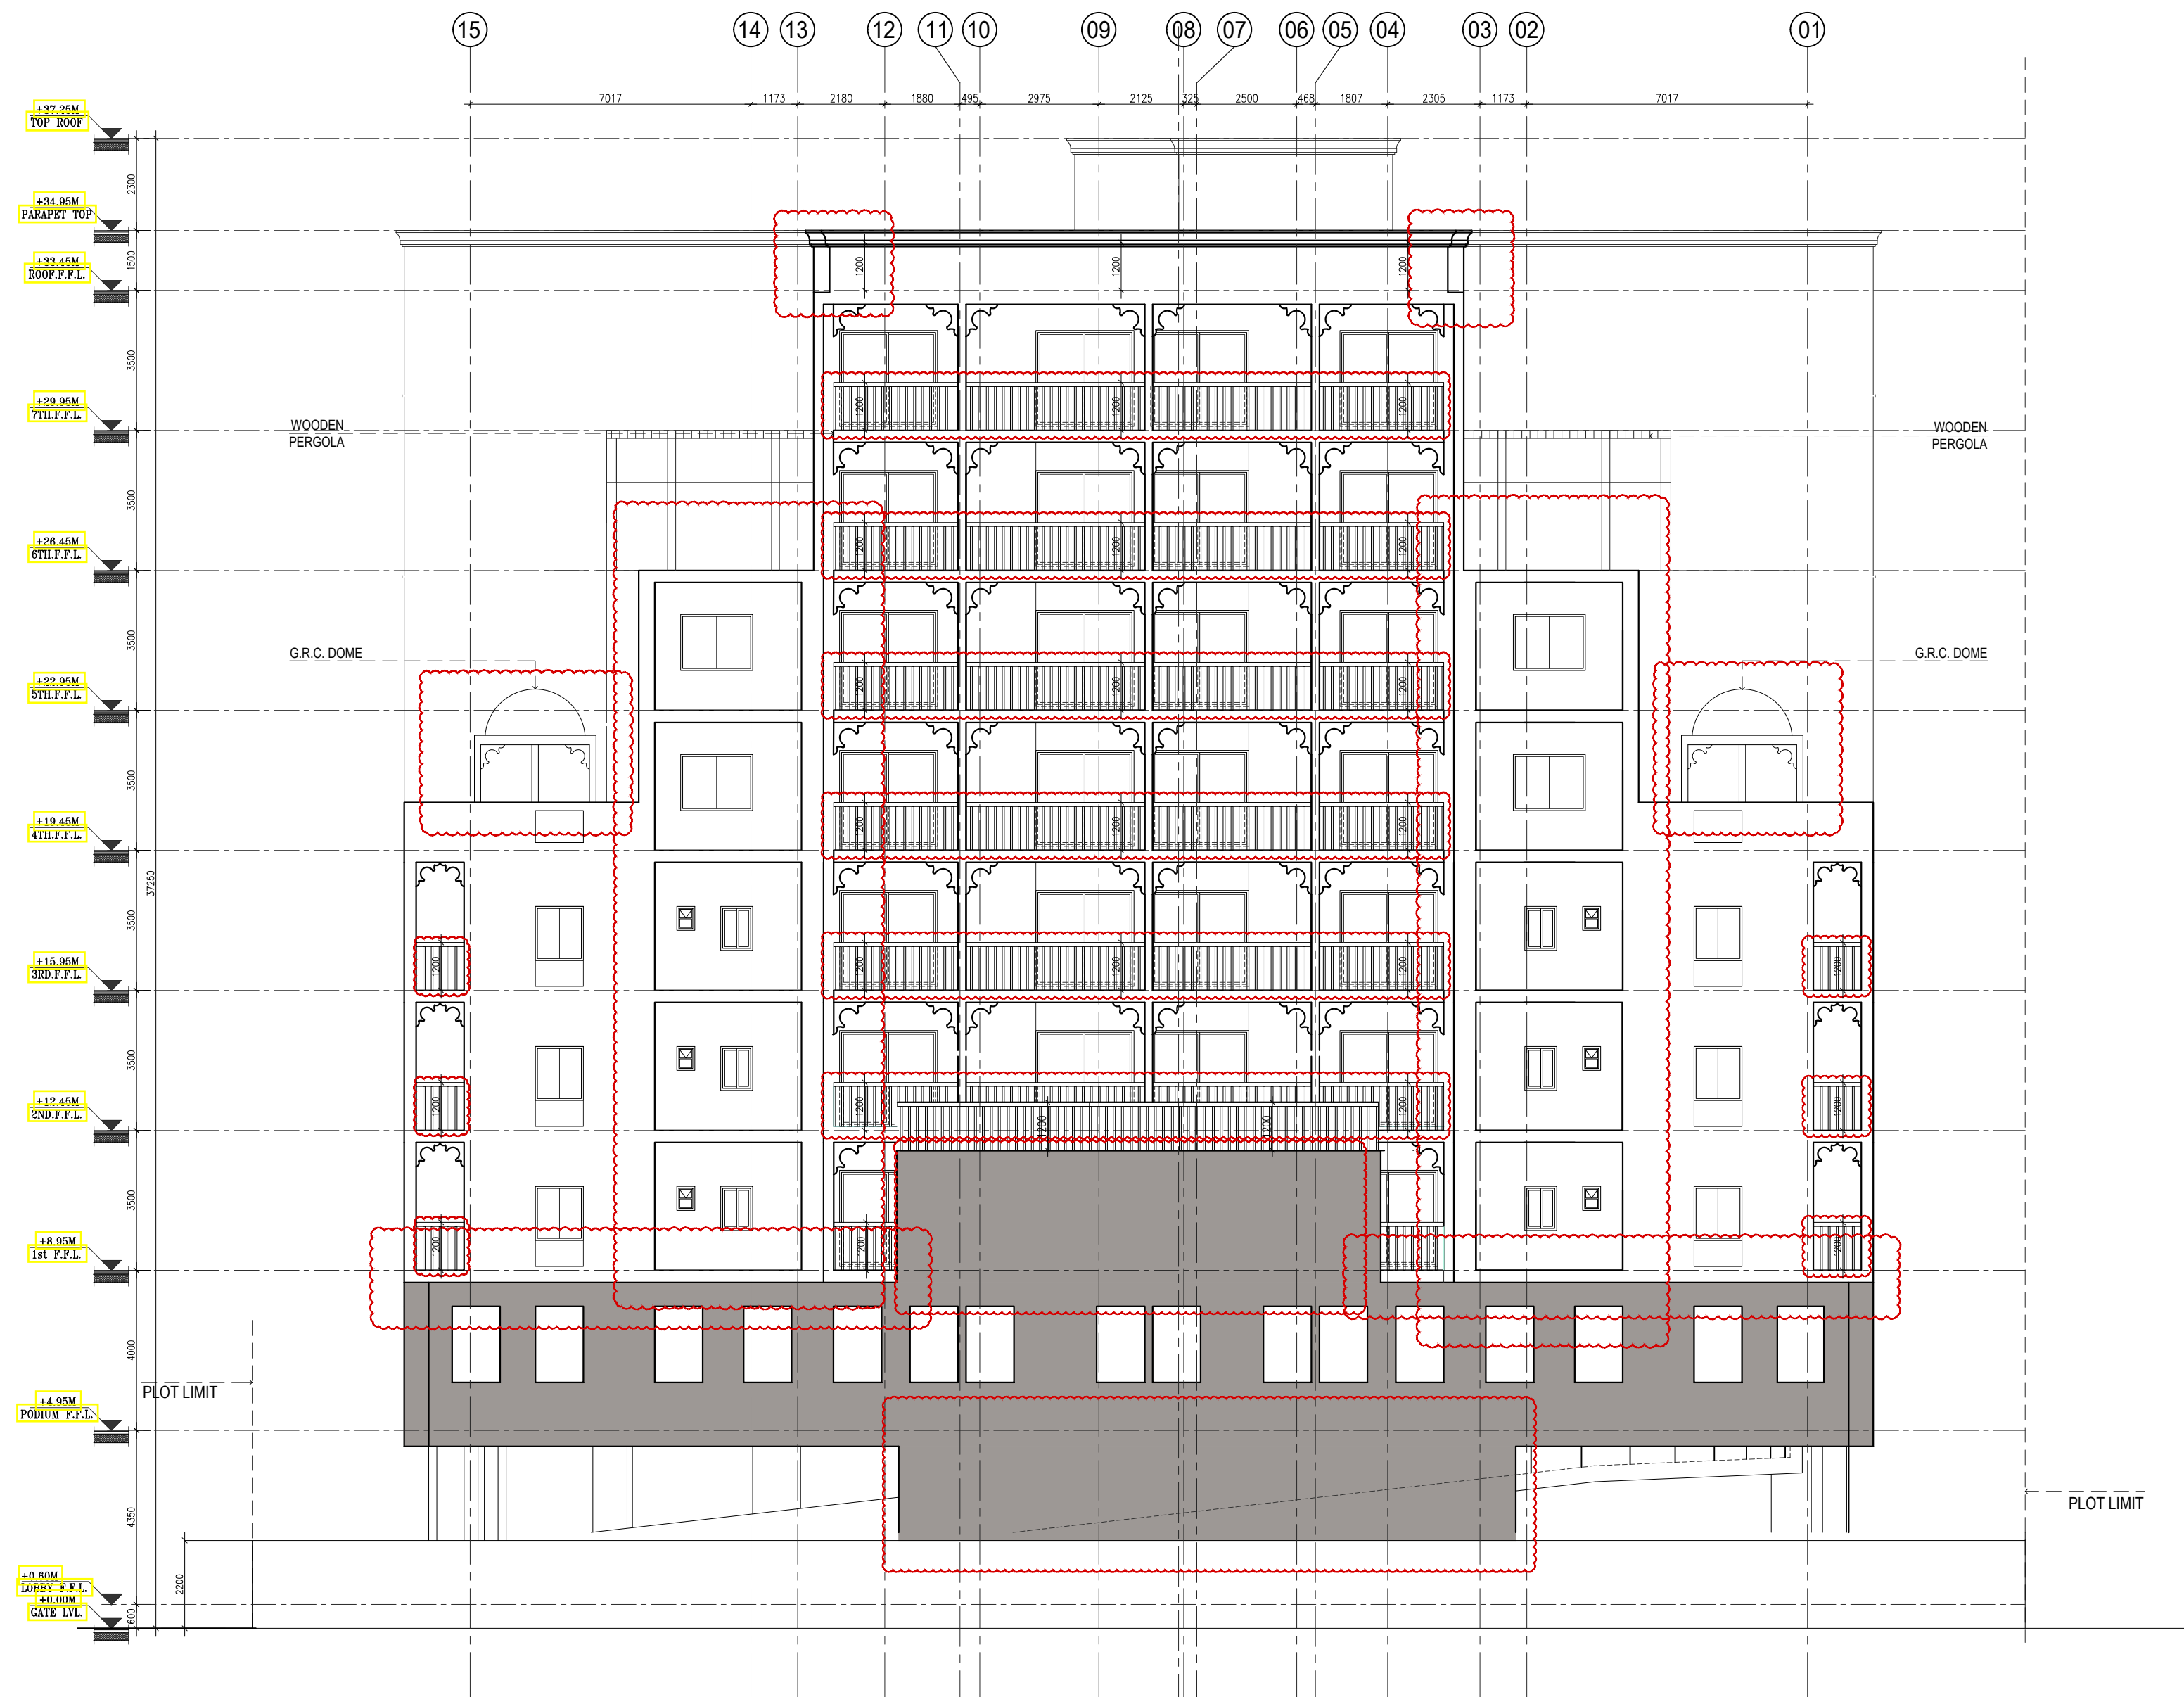

A ELEVATION 3
A-203 1:100

- GENERAL NOTES
1. THIS DRAWING IS THE PROPERTY OF :
na architects engineering consultancy
P.O.Box 237347, DUBAI.
IT IS FORBIDDEN TO PRODUCE IT'S CONTENTS IN
ANY FORM, EXCEPT FOR THE INTENDED PURPOSE.
 2. THIS DRAWING IS NOT TO BE SCALED. THE STATED
DIMENSIONS ONLY ARE TO BE CONSIDERED.
 3. THE DISCREPANCIES ARE TO BE BROUGHT TO THE
ATTENTION AND RESOLVED BY NA ARCHITECTS
ENGINEERING CONSULTANCY BEFORE
COMMENCEMENT OF ANY WORK.
 4. ALWAYS FOLLOWED WRITTEN DIMENSION.

LEGEND

KEY PLAN

AS BUILT

CONTRACTORS REPRESENTATIVES	DATE	INITIALS
CM / PROJECT ENGINEER		
ARCHITECT		
STRUCTURAL ENGINEER		
SUBCONTRACTORS REPRESENTATIVES	DATE	INITIALS
MEP. COORDINATOR		
MECHANICAL ENGINEER		
ELECTRICAL ENGINEER		

PROJECT:			
RESIDENTIAL BUILDING G+1P+7+ROOF			
REVIEW STATUS	☐ A	☐ B	☐ C
DATE REVIEWED			
REVIEWED BY			
DATE:			

AB	02/11/2019	AS BUILT DRAWING SUBMISSION	RCF	Engr. Hazem
Rev	Date	Description	Drawn	Checked

CLIENT :
MR. MASOOD ABDULLA MOHD ABDULAZIZ AL ZAROONI


LOCATION	PLOT No.
IC- PHASE 3	IC3-H-40

PRINCIPAL CONSULTANT:
NA ARCHITECTS ENGINEERING CONSULTANCY ان ايه اركيكتس الاستشارات الهندسية OFFICE 2601 / THE EXCHANGE TOWER BUSINESS BAY - DUBAI - U.A.E TEL: 04-2777820 P.O.BOX: 237347 WWW.NAARCHITECTS.NET

MAIN CONTRACTOR :	MC ALMABNA CONTRACTING COMPANY OFFICE 2601 / THE EXCHANGE TOWER BUSINESS BAY - DUBAI - U.A.E TEL: 04-2777820 P.O.BOX: 237347 WWW.NAARCHITECTS.NET
SUB CONTRACTOR :	MC ALMABNA CONTRACTING COMPANY OFFICE 2601 / THE EXCHANGE TOWER BUSINESS BAY - DUBAI - U.A.E TEL: 04-2777820 P.O.BOX: 237347 WWW.NAARCHITECTS.NET

DRAWING TITLE :		
ELEVATION 3		
DRAWN BY:	JOB NO:	DATE:
RCF	P-10	02.11.2019
CHECKED BY:	SCALE:	SHEET SIZE:
Engr. Hazem	1:100	A1
PROJECT NO:	SHOP DRAWING NO:	REV:
NA/IC/B103 NA/IC/B103/15		AB

AS BUILT

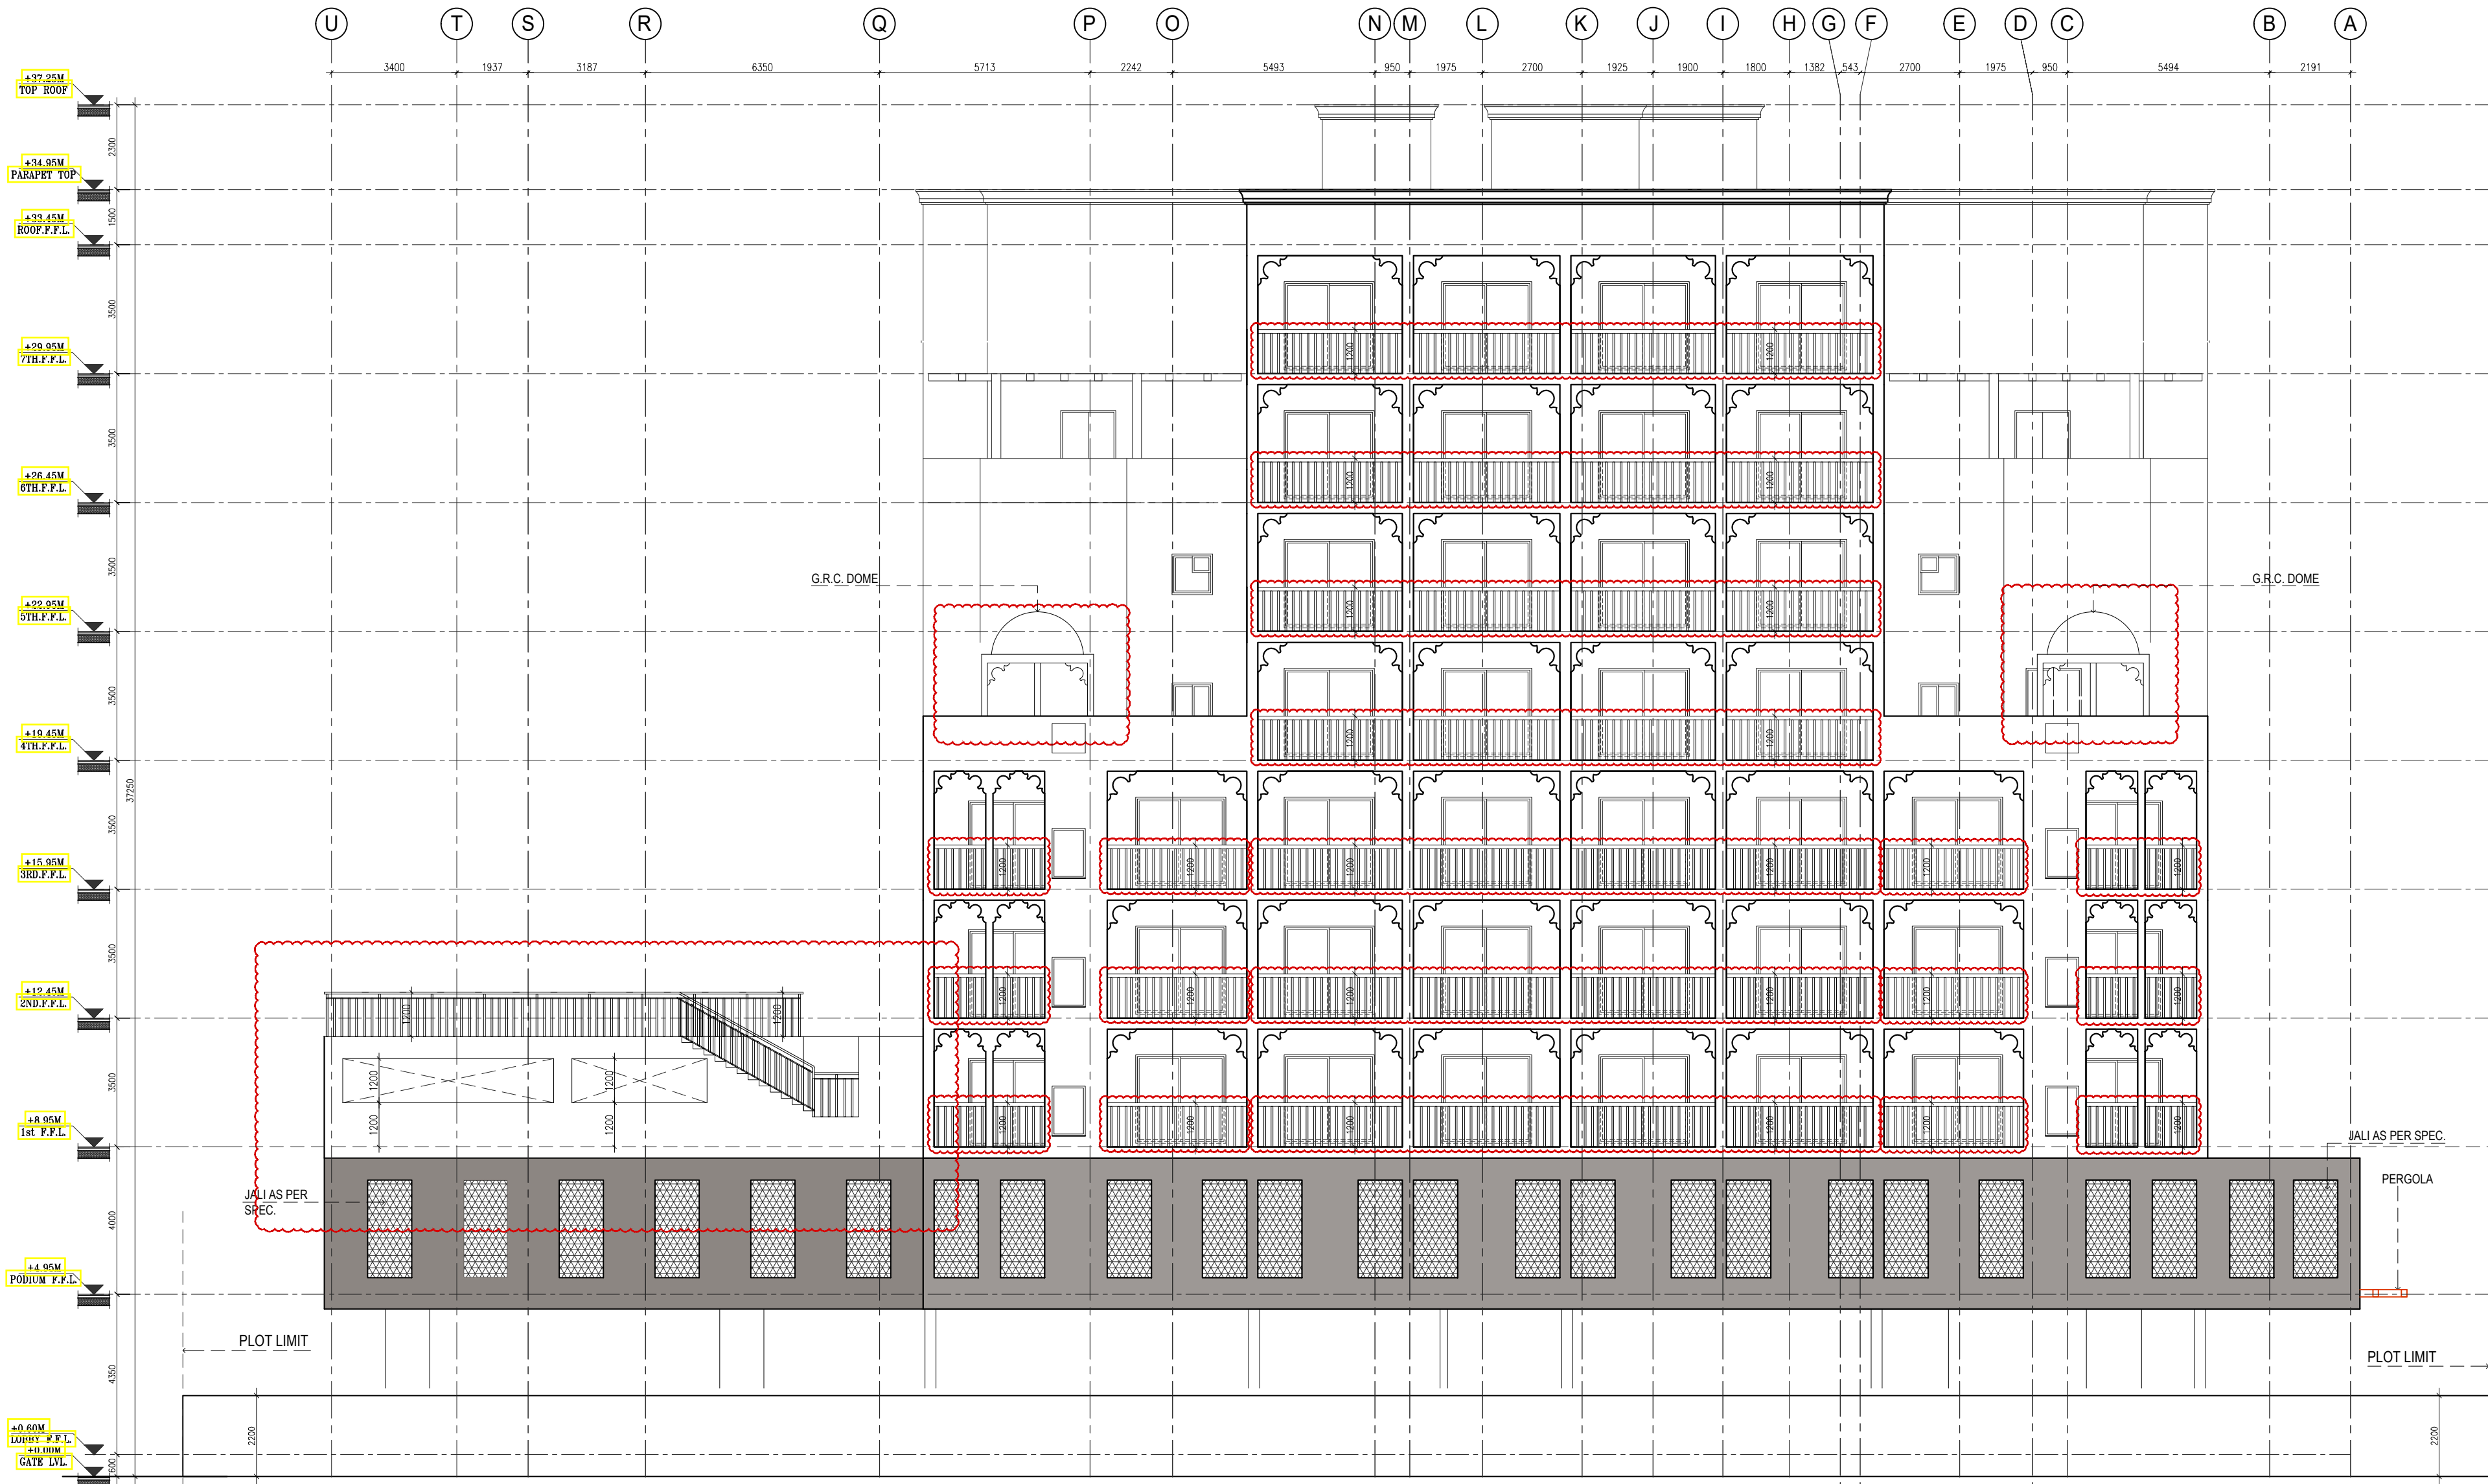

AS BUILT

LEGEND

KEY PLAN

AS BUILT

CONTRACTORS REPRESENTATIVES	DATE	INITIALS
CM / PROJECT ENGINEER		
ARCHITECT		
STRUCTURAL ENGINEER		
SUBCONTRACTORS REPRESENTATIVES	DATE	INITIALS
MEP. COORDINATOR		
MECHANICAL ENGINEER		
ELECTRICAL ENGINEER		

PROJECT:

RESIDENTIAL BUILDING
G+1P+7+ROOF

REVIEW STATUS	☐ A	☐ B	☐ C	☐ D
DATE REVIEWED				
REVIEWED BY				
		DATE:		

AB	02/11/2019	AS BUILT DRAWING SUBMISSION	RCF	Engr. Haze
Rev	Date	Description	Drawn	Checked

CLIENT :

MR. MASOOD ABDULLA MOHD
ABDULAZIZ AL ZAROONI

LOCATION	PLOT No.
IC- PHASE 3	IC3-H-40

PRINCIPAL CONSULTANT:



ان ايه اركيكتس للاستشارات الهندسية
NA ARCHITECTS ENGINEERING CONSULTANCY

OFFICE 2601 / THE EXCHANGE TOWER
 BUSINESS BAY - DUBAI - U.A.E
 TEL: 04-2777820 P.O.BOX: 237347
www.naarchitects.net

MAIN CONTRACTOR :



**ALMABNA
CONTRACTING
COMPANY**
DUBAI, U.A.E.
TEL: 971-4-2656899
FAX: 971-4-2983258
E-MAIL: info@almabna.com

SUB CONTRACTOR :



**ALMABNA
CONTRACTING
COMPANY**
DUBAI, U.A.E.
TEL: 971-4-2656899
FAX: 971-4-2963258
E: almabna@almabna.com
W: www.almabna.com

DRAWING TITLE :

ELEVATION 4

DRAWN BY: RCF	JOB NO: P-10	DATE: 02.11.2019
CHECKED BY: Engr. Hazem	SCALE: 1:100	SHEET SIZE: A1
PROJECT NO: NA/IC/B103 NA/IC/B103/15	SHOP DRAWING NO:	REV: AB



GENERAL NOTES

1. THIS DRAWING IS THE PROPERTY OF :
na architects engineering consultancy
P.O.Box 237347, DUBAI
IT IS FORBIDDEN TO PRODUCE IT'S CONTENTS IN ANY FORM, EXCEPT FOR THE INTENDED PURPOSE.
2. THIS DRAWING IS NOT TO BE SCALED. THE STATED DIMENSIONS ONLY ARE TO BE CONSIDERED.
3. THE DISCREPANCIES ARE TO BE BROUGHT TO THE ATTENTION AND RESOLVED BY NA ARCHITECTS ENGINEERING CONSULTANCY BEFORE COMMENCEMENT OF ANY WORK.
4. ALWAYS FOLLOWED WRITTEN DIMENSION.

LEGEND

KEY PLAN



AS BUILT

CONTRACTORS REPRESENTATIVES		DATE	INITIALS
CM / PROJECT ENGINEER			
ARCHITECT			
STRUCTURAL ENGINEER			
SUBCONTRACTORS REPRESENTATIVES		DATE	INITIALS
MEP. COORDINATOR			
MECHANICAL ENGINEER			
ELECTRICAL ENGINEER			

PROJECT:

RESIDENTIAL BUILDING
G+1P+7+ROOF

REVIEW STATUS	☐ A	☐ B	☐ C	☐
---------------	----------------------------	----------------------------	----------------------------	--------------------------

DATE REVIEWED	
---------------	--

REVIEWED BY	
-------------	--

DATE:

AB	02/11/2019	AS BUILT DRAWING SUBMISSION	RCF	Engr. Hazen
Rev	Date	Description	Drawn	Chked

CLIENT :


MR. MASOOD ABDULLA MOHD
ABDULAZIZ AL ZAROONI

LOCATION	PLOT No.
IC- PHASE 3	IC3-H-40


PRINCIPAL CONSULTANT:



MAIN CONTRACTOR:

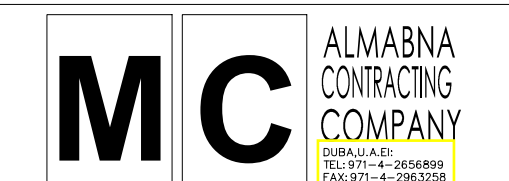


SUB CONTRACTOR:

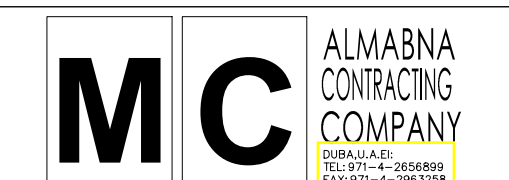

DRAWING TITLE :

SECTION A-A

DRAWN BY: RCF		JOB NO: P-10	DATE: 02.11.2019
CHECKED BY: Engr. Hazem		SCALE: 1:100	SHEET SIZE: A1
PROJECT NO: NA/C/B103		SHOP DRAWING NO:	
NA/C/B103/1/5		REV: A	

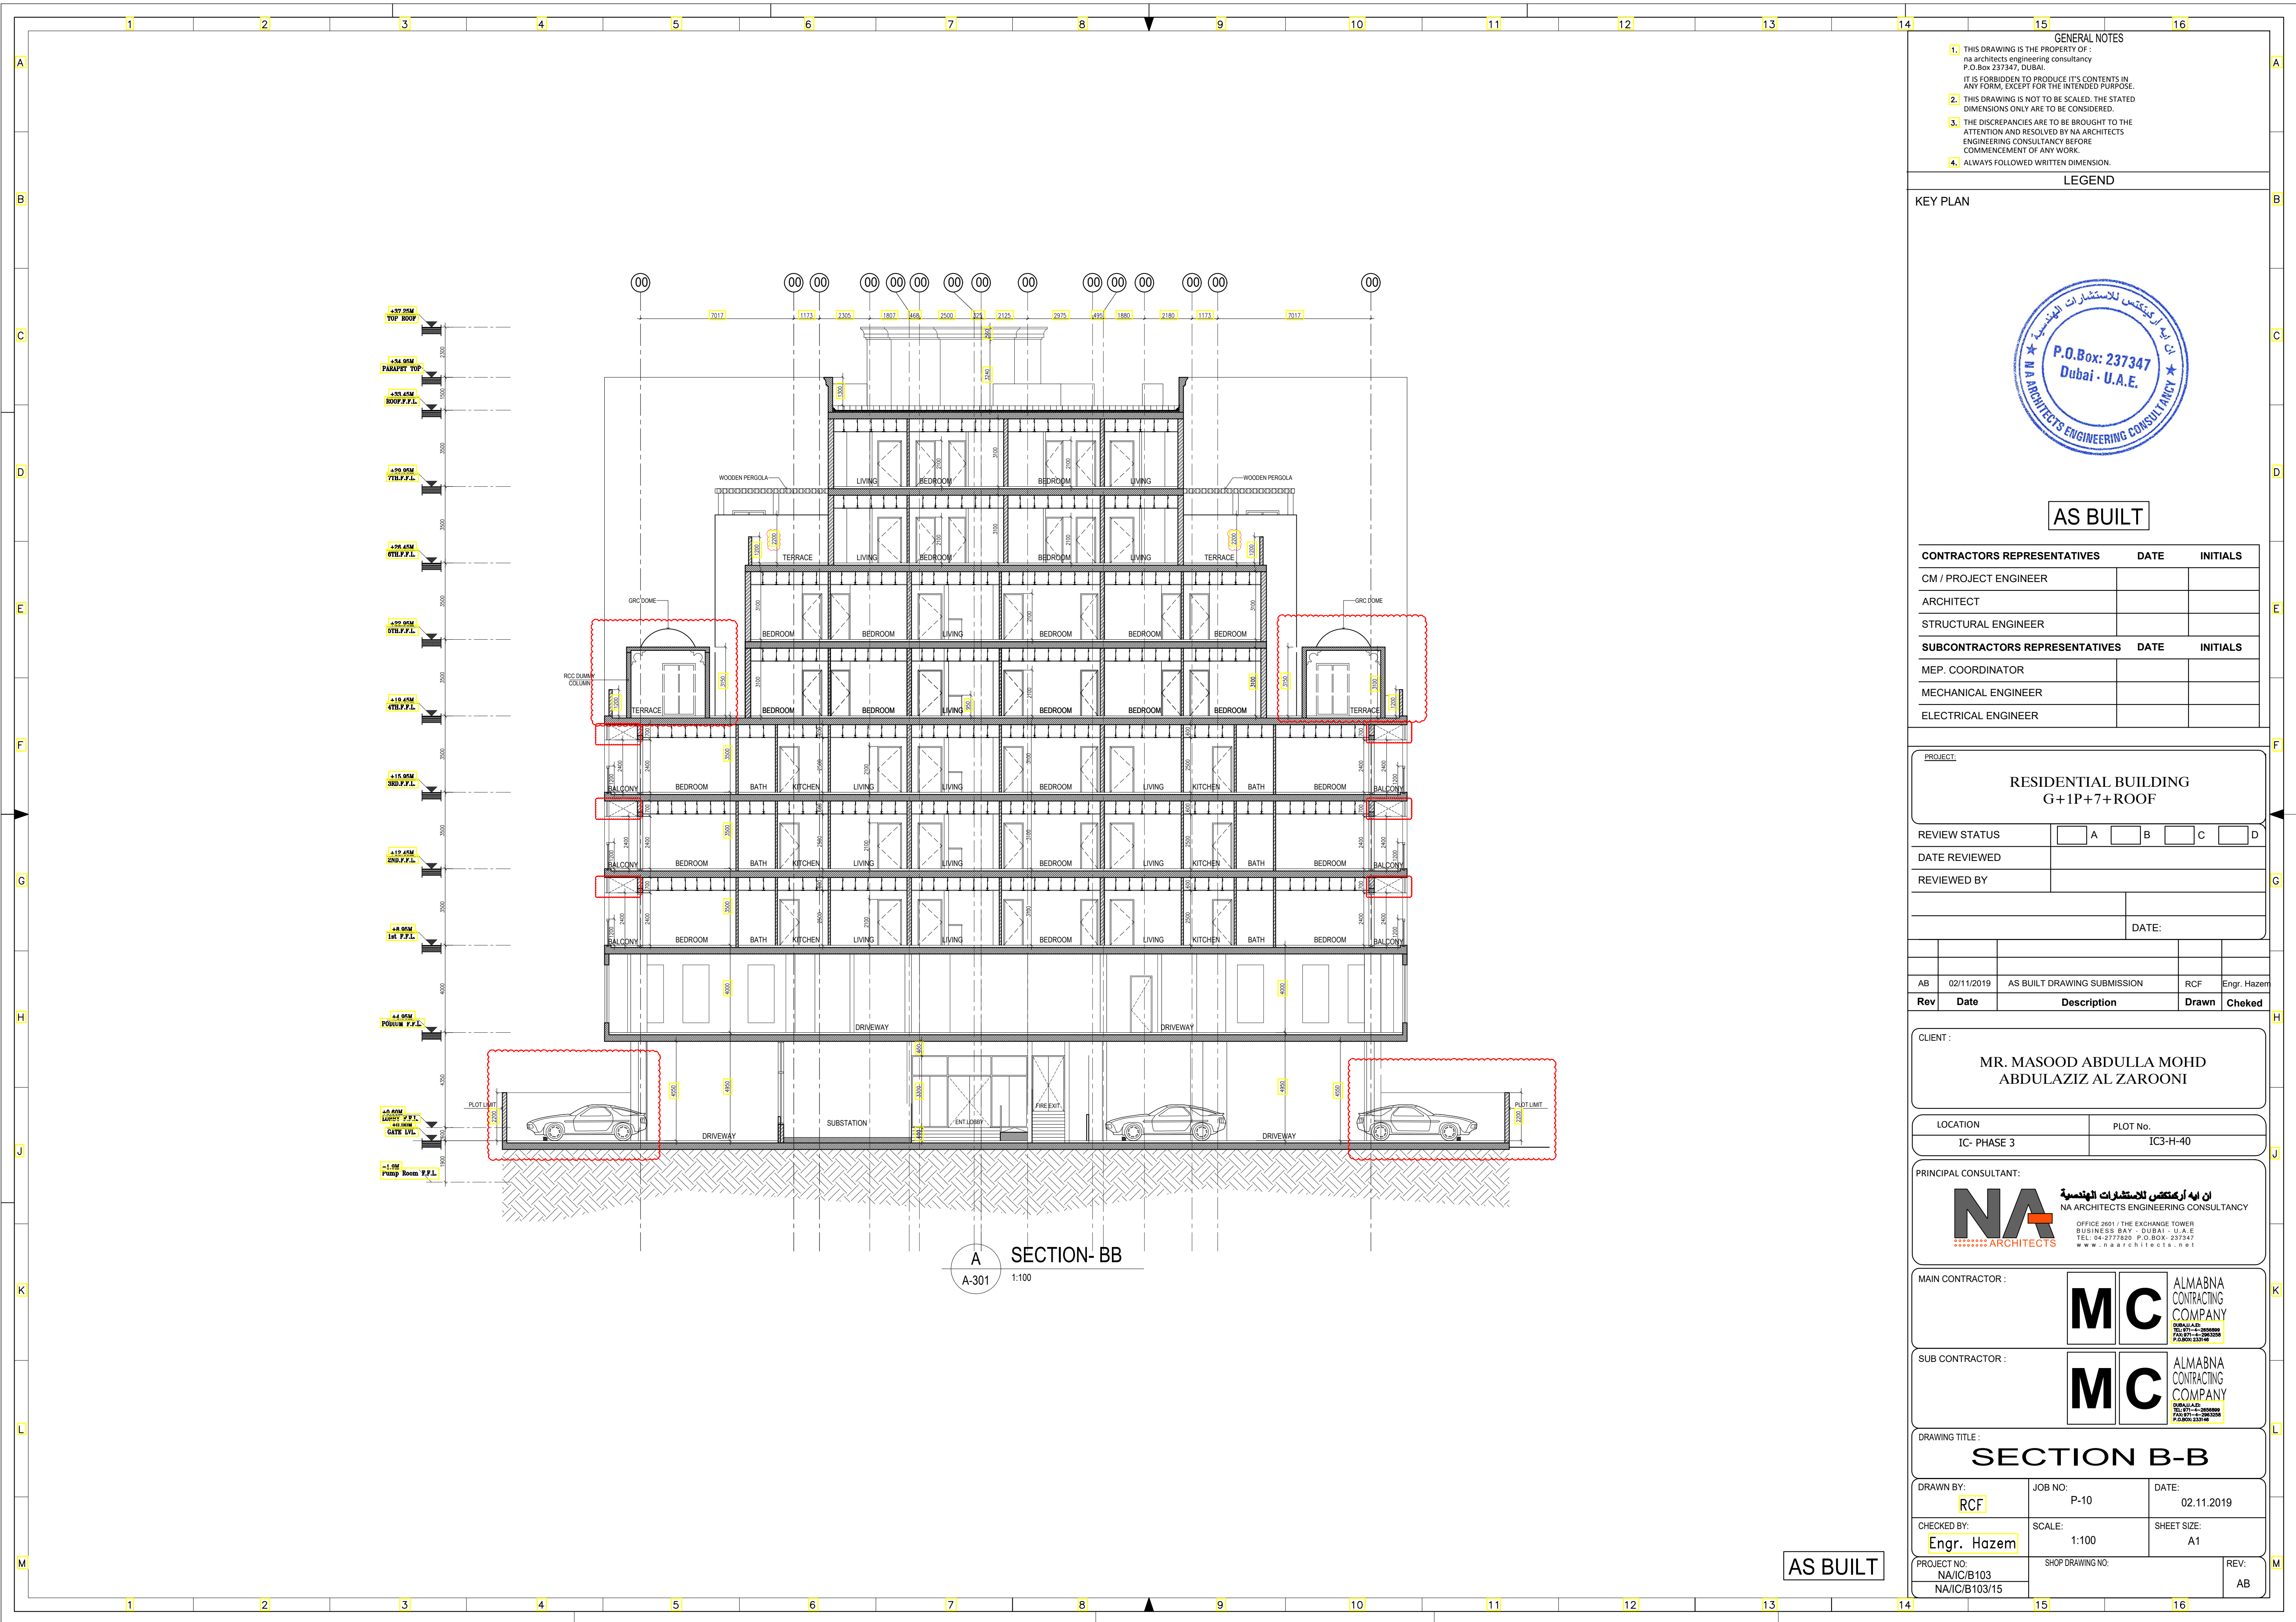

- GENERAL NOTES
1. THIS DRAWING IS THE PROPERTY OF :
na architects engineering consultancy
P.O.Box 237347, DUBAI.
IT IS FORBIDDEN TO PRODUCE IT'S CONTENTS IN
ANY FORM, EXCEPT FOR THE INTENDED PURPOSE.
 2. THIS DRAWING IS NOT TO BE SCALED. THE STATED
DIMENSIONS ONLY ARE TO BE CONSIDERED.
 3. THE DISCREPANCIES ARE TO BE BROUGHT TO THE
ATTENTION AND RESOLVED BY NA ARCHITECTS
ENGINEERING CONSULTANCY BEFORE
COMMENCEMENT OF ANY WORK.
 4. ALWAYS FOLLOWED WRITTEN DIMENSION.

LEGEND

KEY PLAN



AS BUILT

CONTRACTORS REPRESENTATIVES	DATE	INITIALS
CM / PROJECT ENGINEER		
ARCHITECT		
STRUCTURAL ENGINEER		
SUBCONTRACTORS REPRESENTATIVES	DATE	INITIALS
MEP. COORDINATOR		
MECHANICAL ENGINEER		
ELECTRICAL ENGINEER		

PROJECT:

RESIDENTIAL BUILDING
G+1P+7+ROOF

REVIEW STATUS ☐ A ☐ B ☐ C ☐ D

DATE REVIEWED

REVIEWED BY

DATE:

Rev	Date	Description	Drawn	Checked
-----	------	-------------	-------	---------

CLIENT :

MR. MASOOD ABDULLA MOHD
ABDULAZIZ AL ZAROONI

LOCATION	PLOT No.
IC- PHASE 3	IC3-H-40

PRINCIPAL CONSULTANT:

NA **ان ايه ار كيتكس للمشاراات الهندسية**
NA ARCHITECTS ENGINEERING CONSULTANCY
OFFICE 2601 / THE EXCHANGE TOWER
BUSINESS BAY - DUBAI - U.A.E
TEL: 04-2777820 P.O.BOX: 237347
WWW.NAARCHITECTS.NET

MAIN CONTRACTOR :

MC **ALMABNA CONTRACTING COMPANY**
OFFICE 2601 / THE EXCHANGE TOWER
BUSINESS BAY - DUBAI - U.A.E
TEL: 04-2777820 P.O.BOX: 237347
WWW.ALMABNA.CO.UK

SUB CONTRACTOR :

MC **ALMABNA CONTRACTING COMPANY**
OFFICE 2601 / THE EXCHANGE TOWER
BUSINESS BAY - DUBAI - U.A.E
TEL: 04-2777820 P.O.BOX: 237347
WWW.ALMABNA.CO.UK

DRAWING TITLE :

SECTION B-B

DRAWN BY: RCF	JOB NO: P-10	DATE: 02.11.2019
CHECKED BY: Engr. Hazem	SCALE: 1:100	SHEET SIZE: A1
PROJECT NO: NA/IC/B103	SHOP DRAWING NO:	REV: AB